



FALL CREEK REGIONAL WASTE DISTRICT

9378 S. 650 West PO
Pendleton, IN 46064-0059add order
on filerefund
\$250

86

2

APPLICATION FOR SEWER PERMIT

Date

4/20/75

Permit Void 90 days from Date of Issuance

Owner Name

Brian Cotton

Property Address

213 Swain St. 2nd + Swain

Lot #

P.O. Box

Town

Ingalls

, IN

Zip Code

46048

Phone

City Water

Well

\$

2700.00

Tap on Fee Paid

\$

25.00

Inspection fee paid

Application is hereby made for connection to the Fall Creek Regional Waste District Sewer System for the above listed property - Permit Type: Residential ☒, Commercial ☐, Industrial ☐, or Governmental/Institutional ☐. User Information _____.

All workmanship and materials shall conform to the standards of the District Ordinance as described in Ordinance 84-2 and 84-3 as amended. Acceptance and approval must be made by the District inspector or his duly authorized representative before backfilling and final connection is made to the main sewer lines. Any violation of applicable regulations will cause all lines and appurtenances in violation to be removed and replaced at the owners expense.

The Fall Creek Regional Waste District is responsible for the inspection, approval of materials, and installation techniques only. All costs for materials and installation and any liabilities resulting from same is the sole responsibility of the property owner.

I have read and fully understand the above provisions and agree to comply by said provisions.

APPLICANT(S) SIGNATURE

INSPECTOR

Tim

Date inspected

4-8-95

Approved

Rejected

Reason for rejection

Date reinspected

Approved

Rejected

Notes:

Size Pipe

6"

Type Pipe

SDR35

Basement Yes

No

Sump Pump Yes

No

Downspout to Ground Yes

No

Septic Tank Pumped & filled Yes

No

Contractor


Tom Davis

Special Conditions

Existing Home

New Construction

North

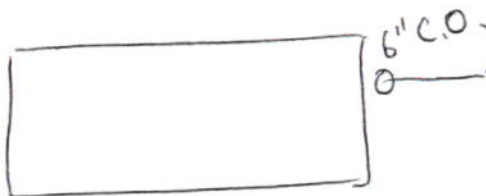



REDBUD ESTATES SALES, INC.
1800 WEST 38TH STREET
ANDERSON, INDIANA 46013

STAR FINANCIAL BANK
ANDERSON, INDIANA 46015

14935

71-167/749

CHECK NO.

***Two Thousand Nine Hundred Seventy-Five & No/100 Dollars

DATE

AMOUNT

04/25/95

***2,975.00

PAY
TO THE
ORDER
OF

Fall Creek Regional Waste District
P.O. Box 59, Co. Rd. 650 West
Pendleton, IN 46064

AUTHORIZED SIGNATURE

⑈014935⑈ ⑈074901672⑈

RECEIPT

FALL CREEK REGIONAL WASTE DISTRICT

P.O. BOX 59, CO. RD. 650 WEST

No 4881

gen

FUND

PENDLETON, IN. 46064,

4/2819 95

RECEIVED FROM

Redbud Estates Sales, Inc.\$2975.00

THE SUM OF

Twenty Nine Hundred seventy five & 00/100

DOLLARS

ON ACCOUNT OF

tap fee / inspection fee for
Brian Cotton, Ingalls

PAID BY: CASH



CHECK



M.O.

14935Hebbie Wilson

AUTHORIZED SIGNATURE