



FALL CREEK REGIONAL WASTE DISTRICT

9378 S. 650 West PO Box 59  
Pendleton, IN 46064-0059 778-7544

1-02618.05

APPLICATION FOR SEWER PERMIT

No 2725

Date 1-12-2000

Permit Void 90 days from Date of Issuance

Owner Name Julie Waszak

Property Address 213 S. Main St.

Lot #

P.O. Box

Town

IN Zip Code

Phone

City Water

Well

\$ N/A

Tap on Fee Paid

Lateral Replacement

\$ N/A

Inspection fee paid

Application is hereby made for connection to the Fall Creek Regional Waste District Sewer System for the above listed property - Permit Type: Residential, Commercial, Industrial, or Governmental/Institutional. User Information

All workmanship and materials shall conform to the standards of the District Ordinance as described in Ordinance 84-2 and 84-3 as amended. Acceptance and approval must be made by the District inspector or his duly authorized representative before backfilling and final connection is made to the main sewer lines. Any violation of applicable regulations will cause all lines and appurtenances in violation to be removed and replaced at the owners expense.

The Fall Creek Regional Waste District is responsible for the inspection, approval of materials, and installation techniques only. All costs for materials and installation and any liabilities resulting from same is the sole responsibility of the property owner.

I have read and fully understand the above provisions and agree to comply by said provisions.

APPLICANT(S) SIGNATURE

INSPECTOR Ben Dow

Date inspected 1-12-00

Approved

Rejected

Reason for rejection

Date reinspected

Approved

Rejected

Notes:

Size Pipe

6

Type Pipe

PVC

Basement Yes

No X

Sump Pump Yes

No X

Downspout to Ground Yes X No


Septic Tank Pumped & filled Yes No X

Contractor John Long

Special Conditions

Existing Home X

New Construction

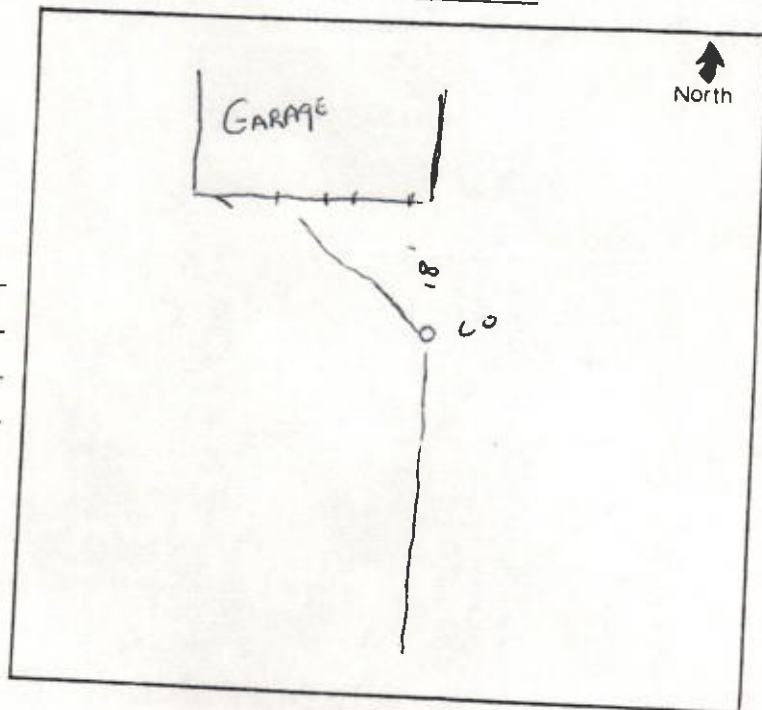



FALL CREEK REGIONAL WASTE DISTRICT  
 5338 S. 650 West PO Box 59  
 Pendleton, IN 46064-0059 778-7544

1-02618-02

No 2722

APPLICATION FOR SEWER PERMIT

Date 1-12-2000

Permit Valid 90 days from date of issuance

Owner Name Julie Wozniak

Property Address 213 S. Main St.

Lot # \_\_\_\_\_ P.O. Box \_\_\_\_\_

Town \_\_\_\_\_ IN Zip Code \_\_\_\_\_

Phone \_\_\_\_\_ City Water \_\_\_\_\_ Well \_\_\_\_\_

Tap on the line N/A

Inspection fee paid N/A

Application is hereby made for connection to the Fall Creek Regional Waste District Sewer System for the above listed property - Permit Type: Residential \_\_\_\_\_ Commercial \_\_\_\_\_ Industrial \_\_\_\_\_ or Governmental \_\_\_\_\_ User Information \_\_\_\_\_

All workmanship and materials shall conform to the standards of the District Ordinance as described in Ordinance 84-3 and 84-7 as amended. Acceptance and approval must be made by the District Inspector or his duly authorized representative before backfilling and final connection is made to the main sewer line. Any violation of applicable regulations will cause all lines and appurtenances in violation to be removed and replaced at the owner's expense.

The Fall Creek Regional Waste District is responsible for the inspection, approval of materials, and installation techniques only. All costs for materials and installation and any liabilities resulting therefrom are the sole responsibility of the property owner.

I have read and fully understand the above provisions and agree to comply by said provisions.

APPLICANT(S) SIGNATURE \_\_\_\_\_

INSPECTOR SIGNATURE [Signature]

Date Inspected 1-12-00 Approved ☒ Rejected ☐

Reason for rejection \_\_\_\_\_

Date re-inspected \_\_\_\_\_ Approved ☐ Rejected ☐

Notes:

Size pipe 6"

Type pipe PVC

Basement Yes ☐ No ☒

Shop Pump Yes ☐ No ☒

Downspout to Street Yes ☒ No ☐

Septic Tank Pumped & Filled Yes ☐ No ☒

Contractor John Long

Special Conditions \_\_\_\_\_

Existing Home ☒

New Construction \_\_\_\_\_

