

Gidw.

PROJECT Phase II SHEET _____ OF _____


SUBJECT _____ DATE 3-28-18

JOB NO. 4447

BY Atlas

214 S. West

West

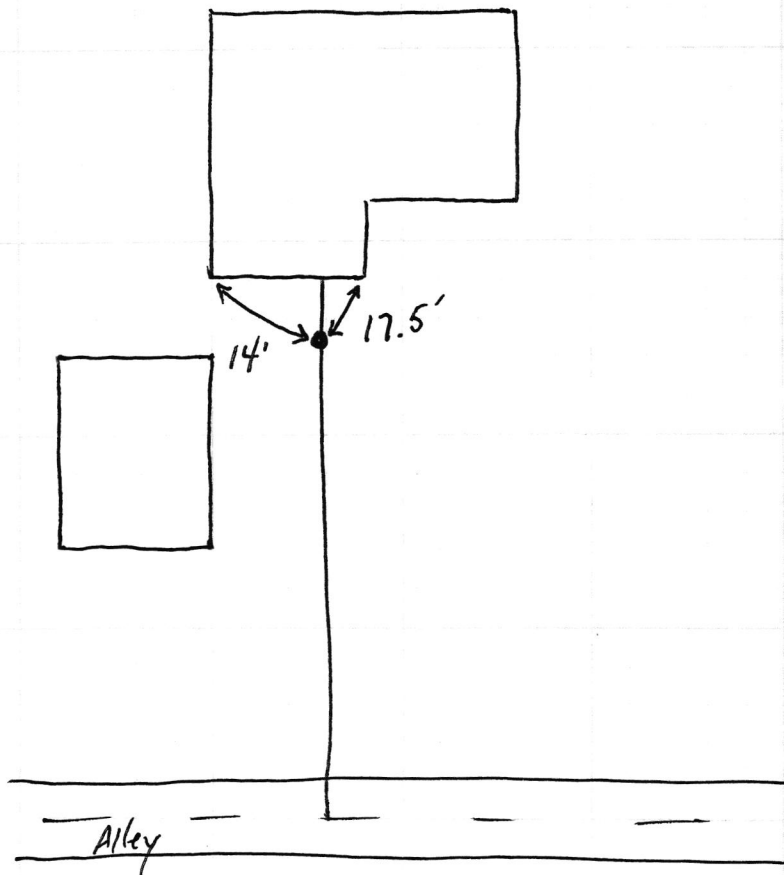

214 S West

SRP Phase II

