

Gidw.


PROJECT Phase II SHEET _____ OF _____

SUBJECT _____ DATE 8-6-18

JOB NO. 4447

BY Atlas

215 N. Pendleton ← N

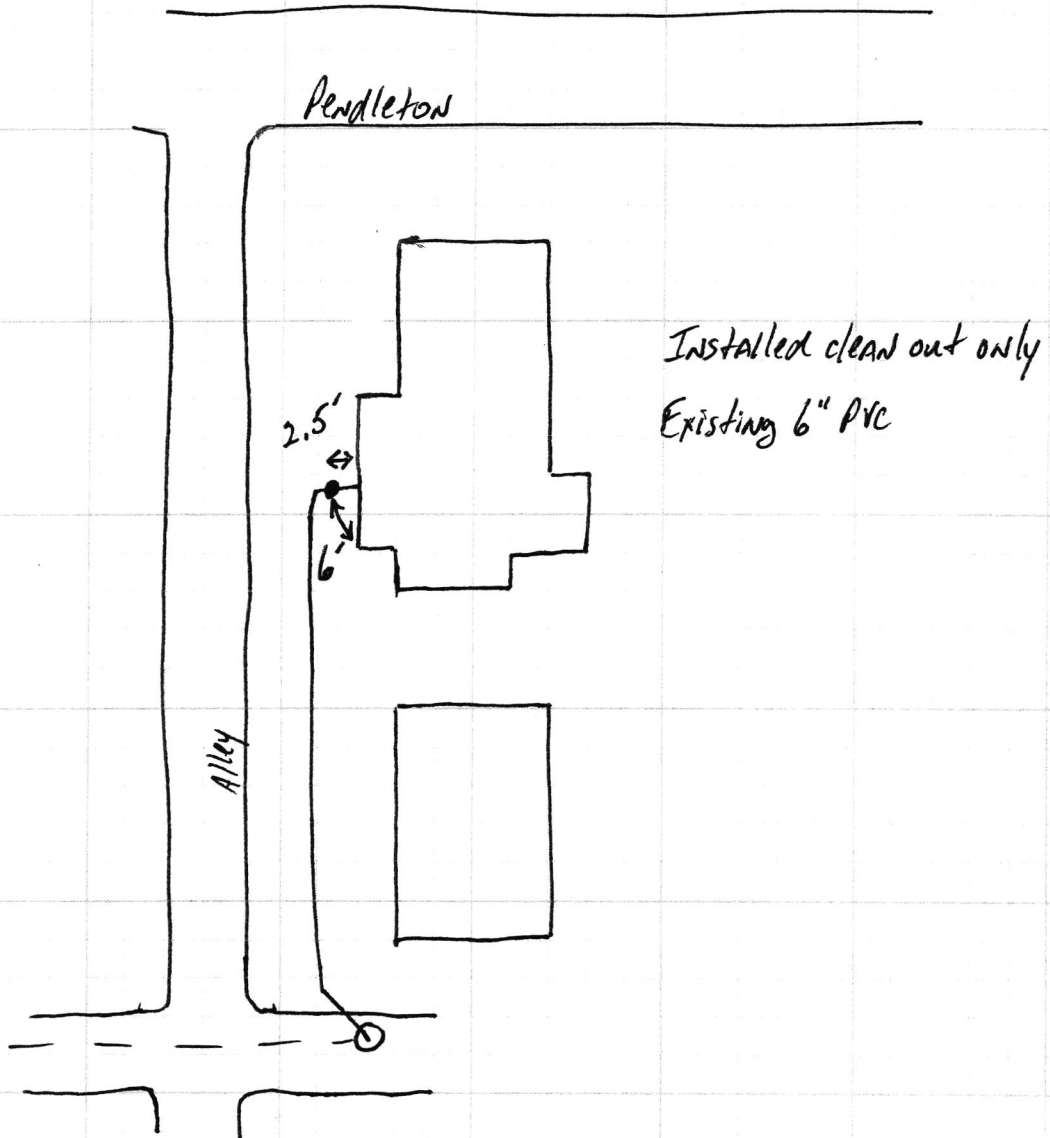

Site 1: 10/10/18

Site Phase II

8.15.18

