






215 Pearl ST

SRF Phase II

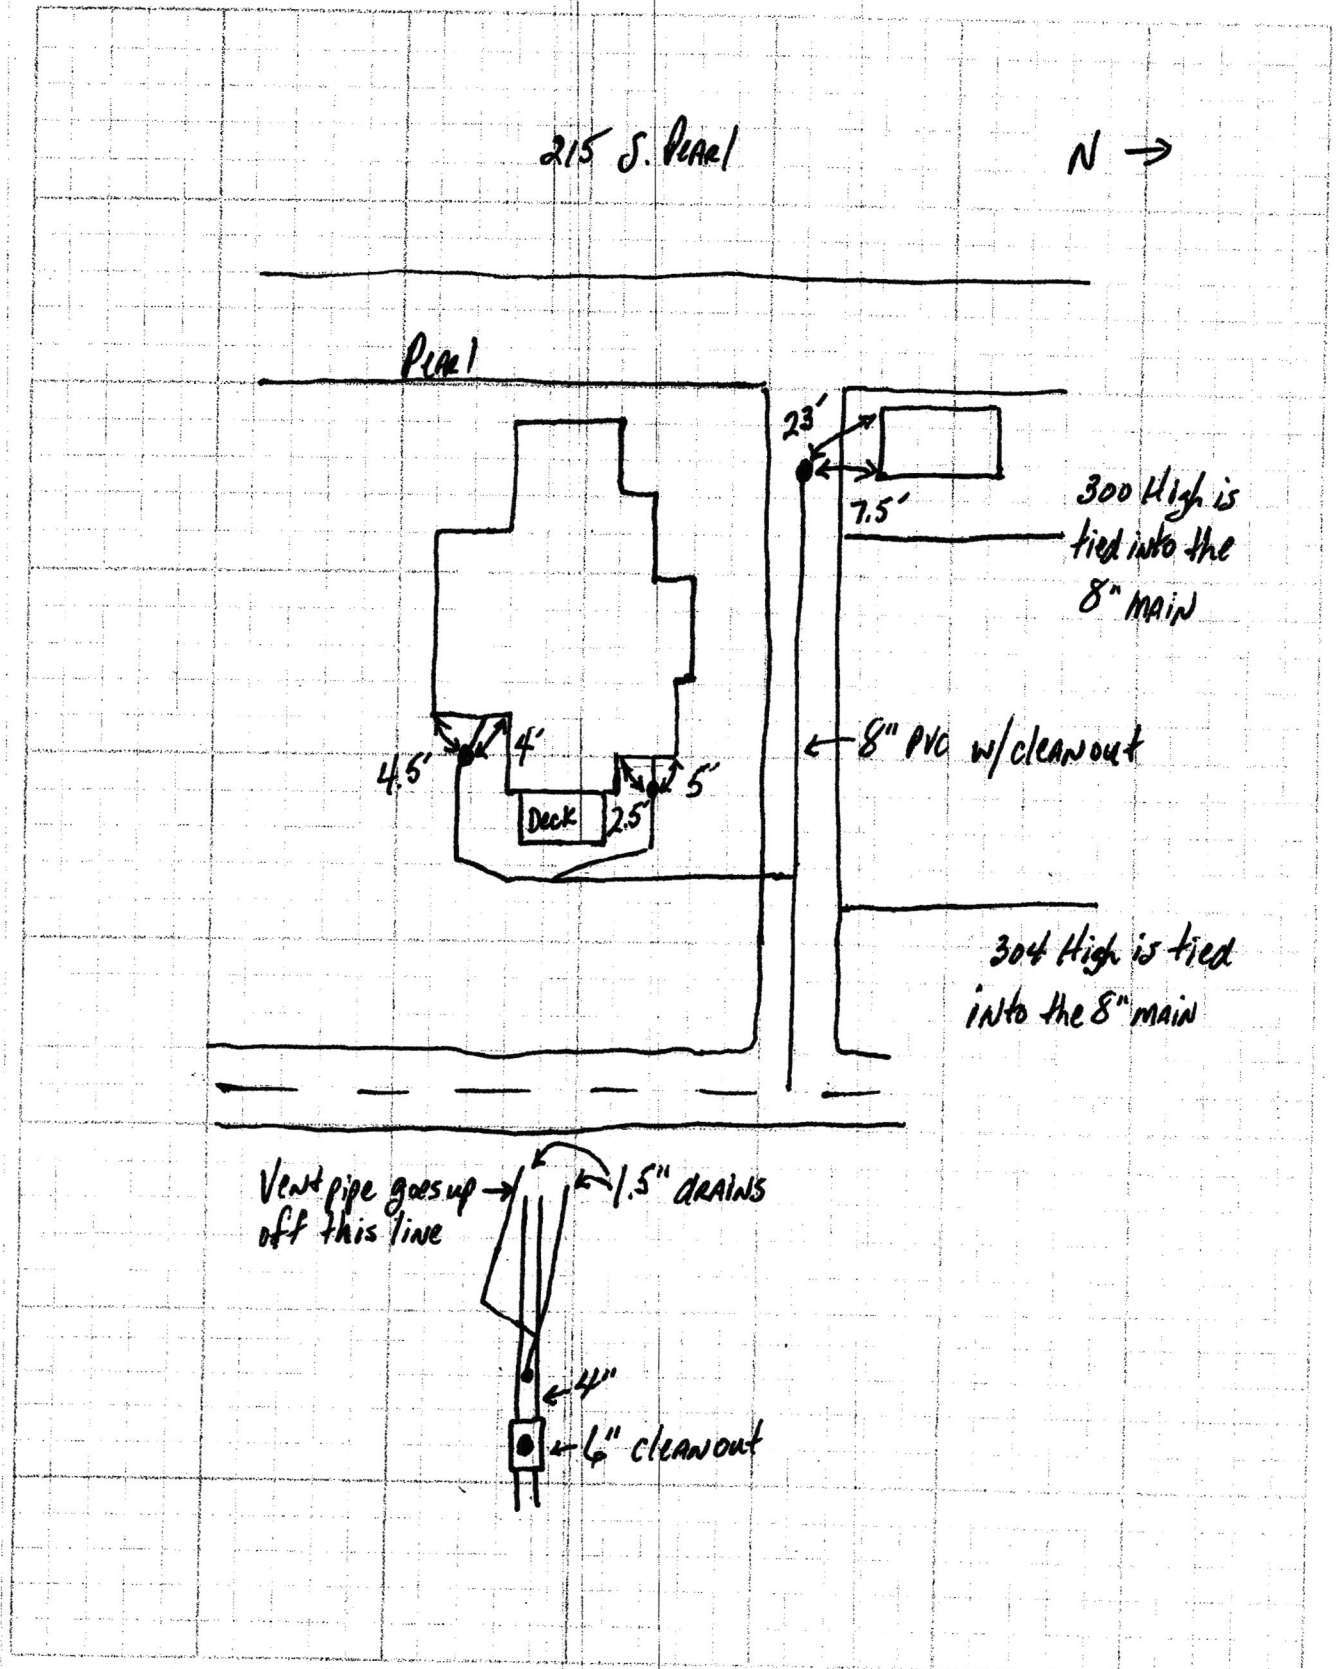



215 Year 1

SIF Phase II

7.11.18



Gidw.

PROJECT

Phase II

SHEET

OF

SUBJECT

DATE

7-9-18

JOB NO

4447

BY

Atlas

215 S. Pearl

N →

