

Side


PROJECT Phase II SHEET _____ OF _____

SUBJECT _____ DATE 2-8-18

JOB NO. 4447

BY Atlas

215 W. Taylor

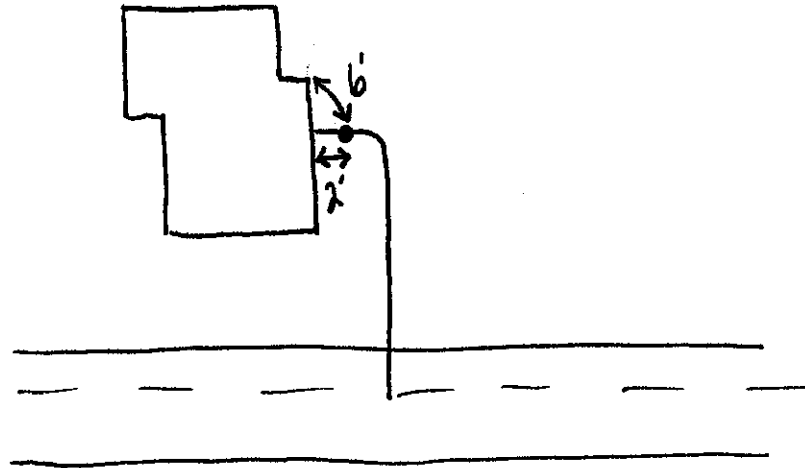

215 W Taylor

SRP Phase II

2.8.18

