


Gidw.

PROJECT Phase II SHEET _____ OF _____
SUBJECT _____ DATE 2-16-18
JOB NO. 4447
BY Atlas

216 E. High

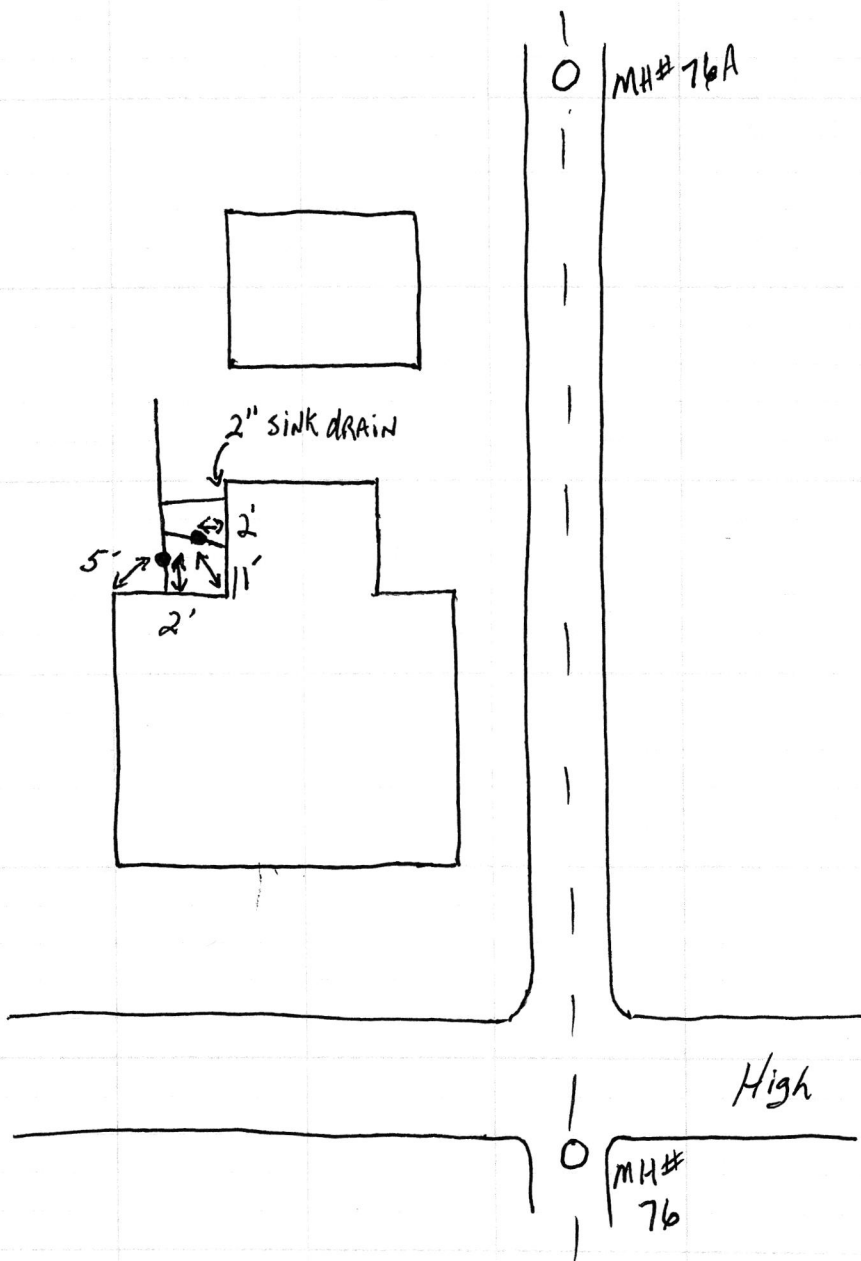

2018 2 High SPF Phase II

2018

