

GIRL

PROJECT Phase II SHEET _____ OF _____


SUBJECT _____ DATE 3-16-18

JOB NO. 4447

BY Atlas


216 Franklin

Franklin

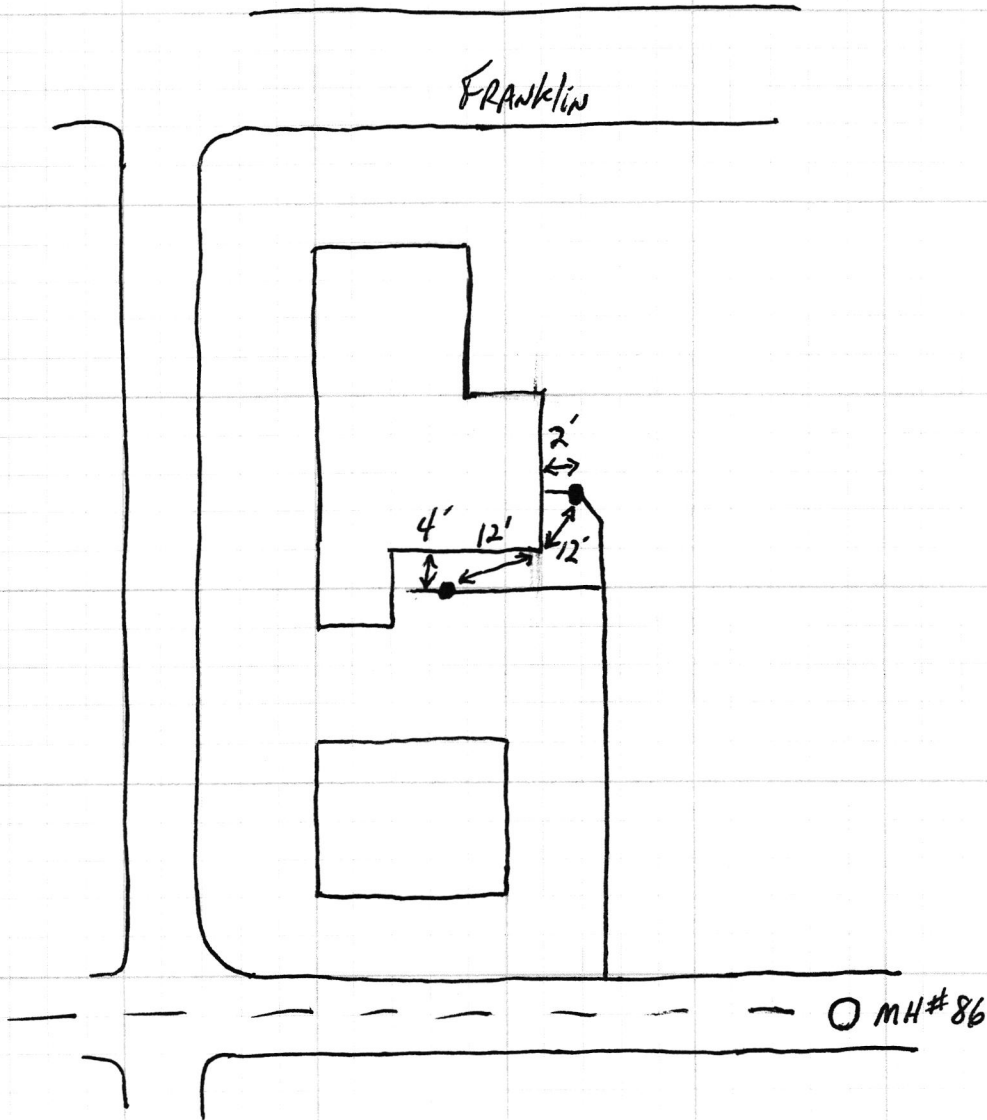

216 Franklin

SRP Phase II

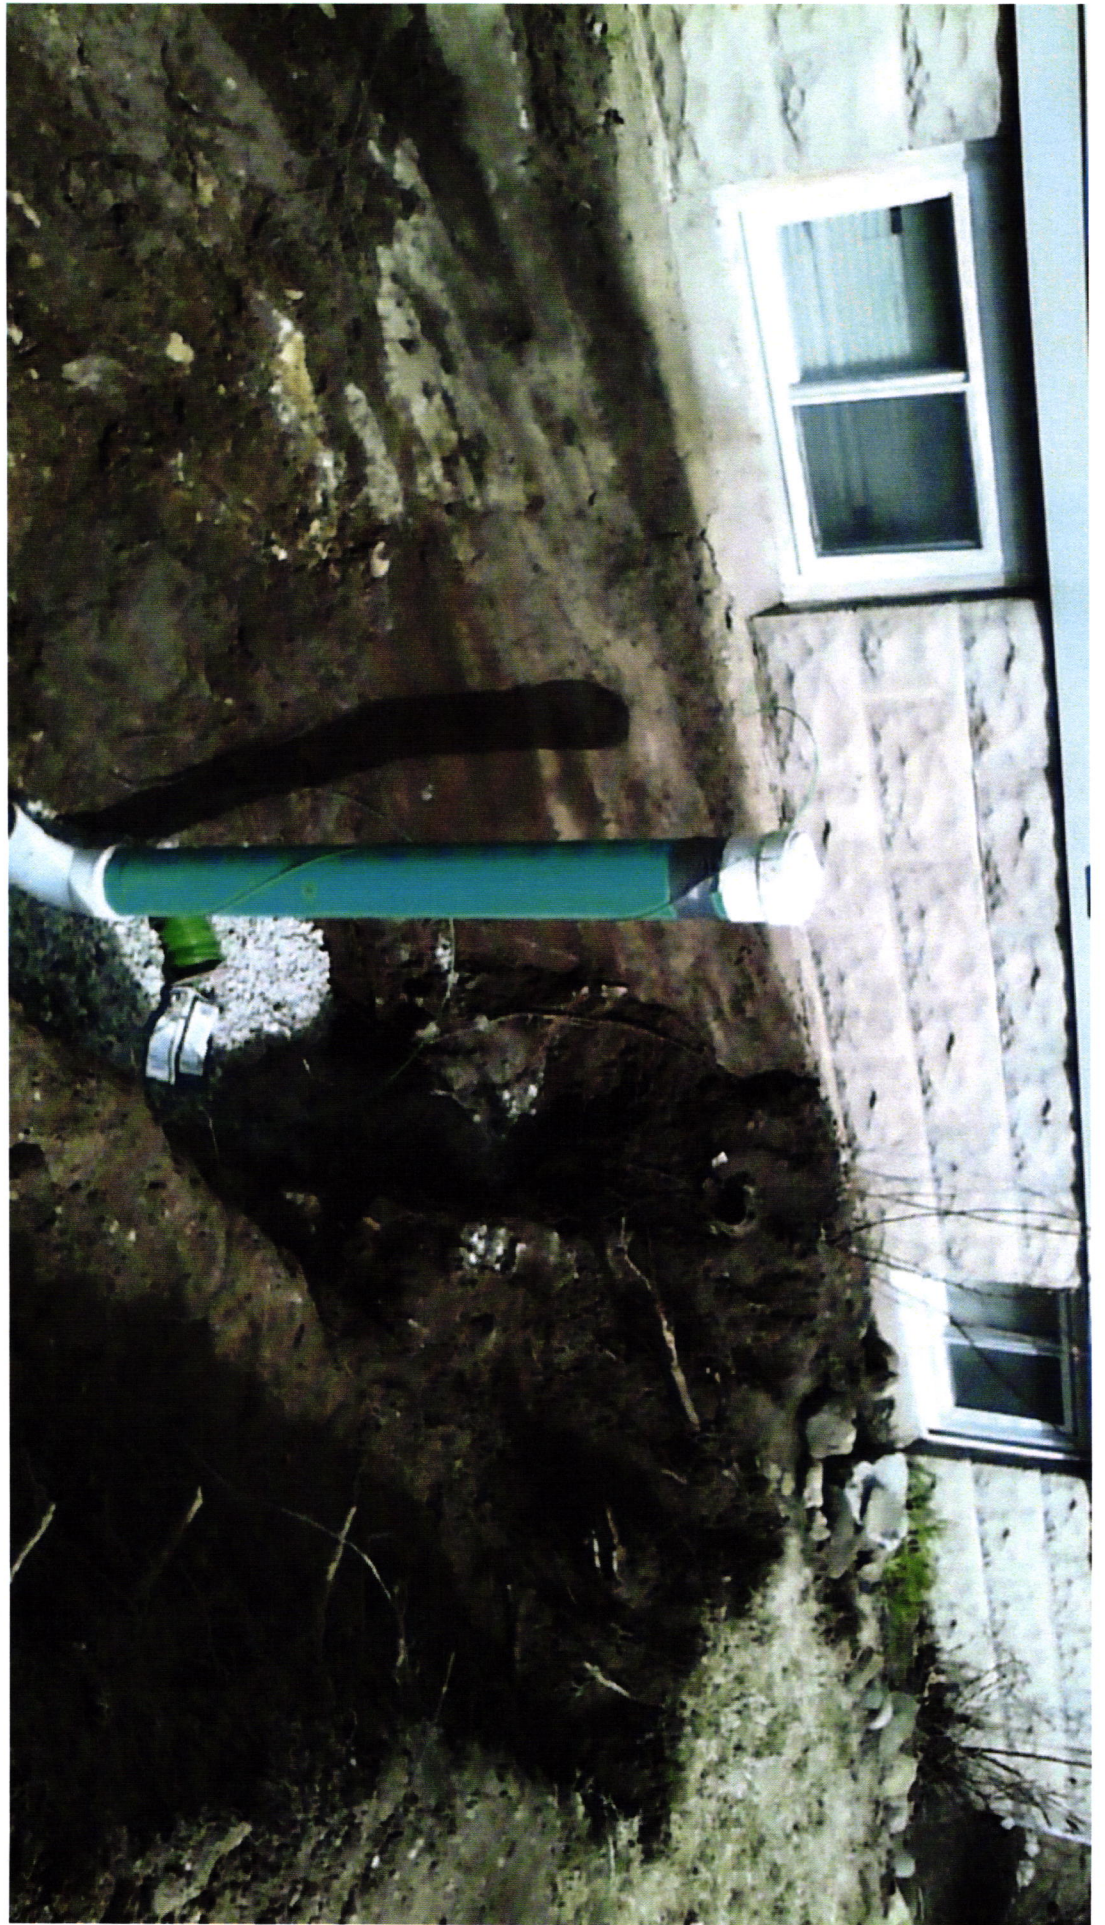

216 Franklin

SRP Phase II

