

Gidw.


PROJECT Phase II SHEET _____ OF _____

SUBJECT _____ DATE 4-9-18

JOB NO. 4447

BY Atlas

216 S. Jefferson

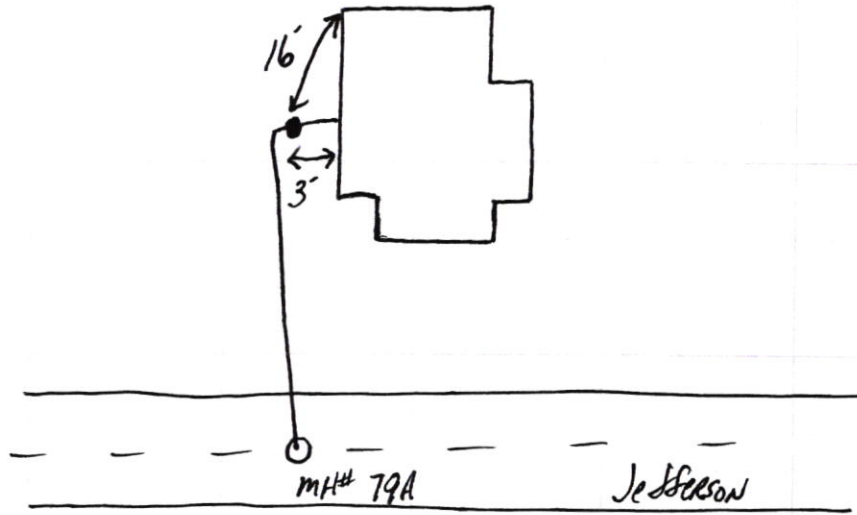

216 S Jefferson

S&F
Phase II

4.11.18

