

Gidw.


PROJECT Phase II SHEET _____ OF _____

SUBJECT _____ DATE 4-11-18

JOB NO. 4447

BY Atlas

216 S. Main

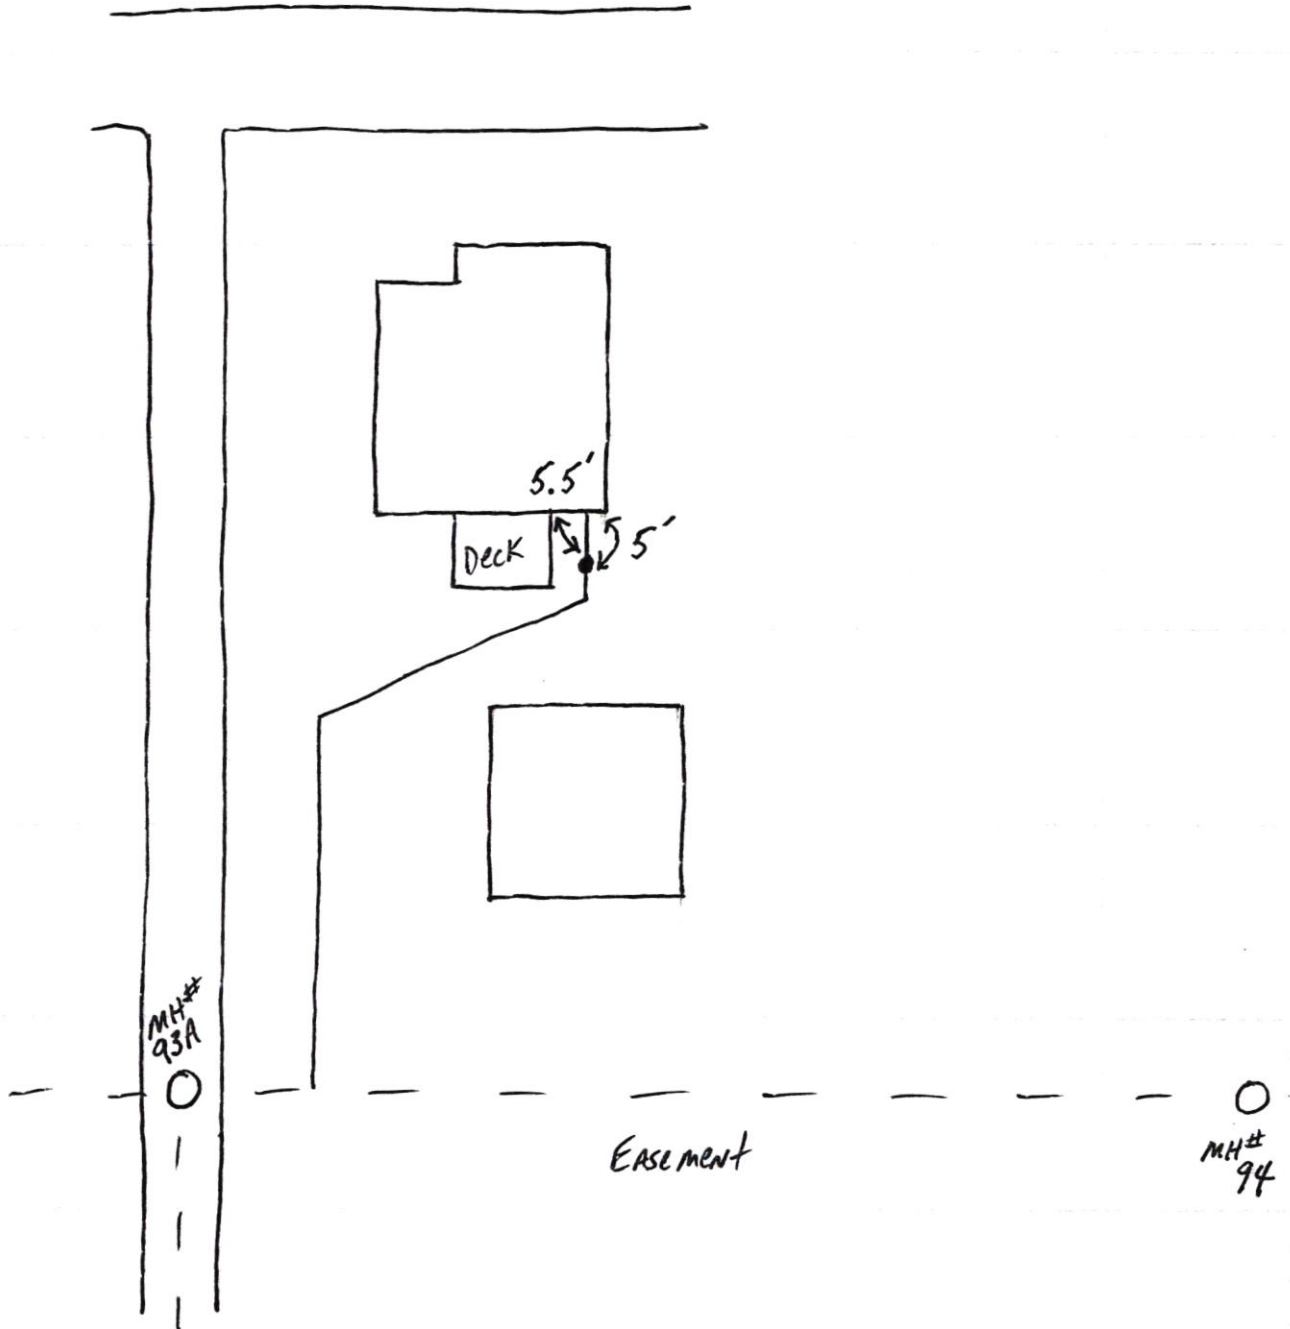

216 S Main

SRP
Phase II

4.20.18

