


Gidw.

PROJECT Phase II SHEET _____ OF _____
SUBJECT _____ DATE 1-29-18
JOB NO 4447
BY Atlas

216 W. Tile

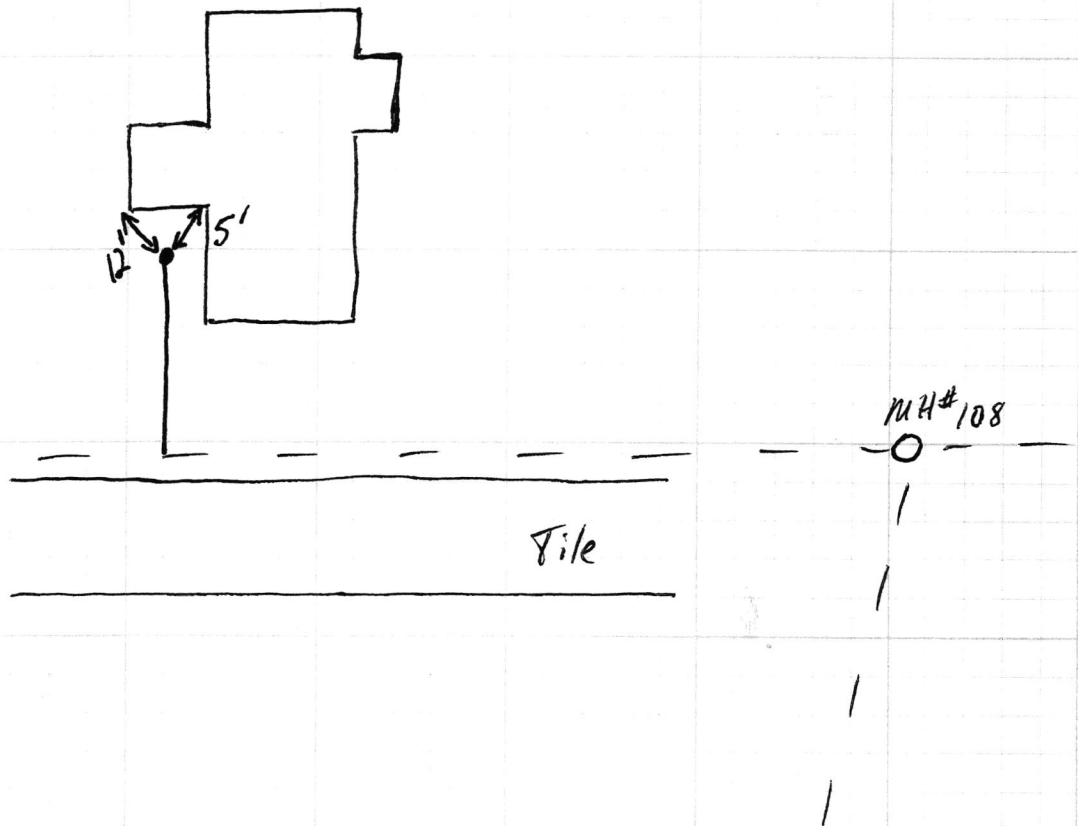

220 W Tile
ane

SRF Phase II

