

Gidw.

PROJECT Phase II

SHEET _____ OF _____



SUBJECT _____

DATE 4-10-18

JOB NO. 4447

BY Atlas

216 W. Elm

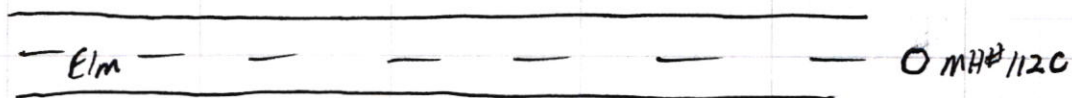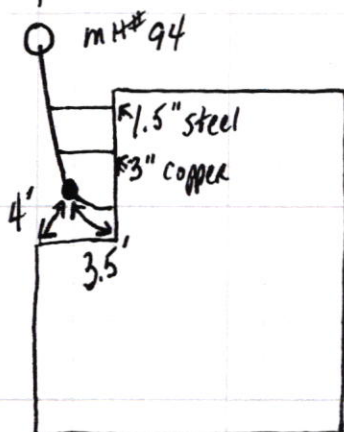

210 W Elm

SRP
Phase II

4.20.18

