

Gidw.

PROJECT Phase II SHEET _____ OF _____


SUBJECT _____ DATE 6-13-18

JOB NO. 4447

BY Atlas

217 E. Indiana

↑
N

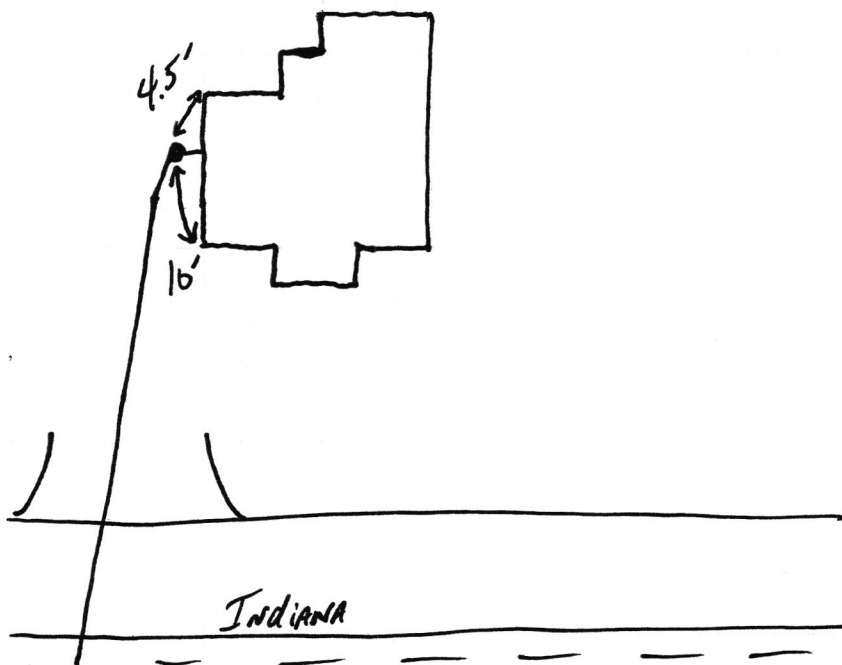

q17 Indiana

S&F Phase II

6.19.18

