



## FALL CREEK REGIONAL WASTE DISTRICT

Box 44, Pendleton, Indiana 46064

add order on  
file

22-26075.00

Aug. 25.

Nº 001848

## APPLICATION FOR SEWER PERMIT

Permit No. \_\_\_\_\_ Date 5/28/92  
Permit Void 90 days from Date of Issuance  
Owner Name Eric & Anne Perkins  
Property Address 217 Lucky Lane Merry Hills  
Lot # 51 P.O. Box \_\_\_\_\_  
Town Pendleton, IN Zip Code 46064  
Phone \_\_\_\_\_ Water Meter \_\_\_\_\_"  
\$ 700.00 Tap on Fee Paid  
\$ 25.00 Inspection fee paid

Application is hereby made for connection to the Fall Creek Regional Waste District Sewer System for the above listed property - Permit Type: Residential X, Commercial \_\_\_\_\_, Industrial \_\_\_\_\_, or Governmental/Institutional \_\_\_\_\_. User Information \_\_\_\_\_.

All workmanship and materials shall conform to the standards of the District Ordinance as described in Ordinance 84-2 and 84-3 as amended. Acceptance and approval must be made by the District inspector or his duly authorized representative before backfilling and final connection is made to the main sewer lines. Any violation of applicable regulations will cause all lines and appurtenances in violation to be removed and replaced at the owners expense.

The Fall Creek Regional Waste District is responsible for the inspection, approval of materials, and installation techniques only. All costs for materials and installation and any liabilities resulting from same is the sole responsibility of the property owner.

I have read and fully understand the above provisions and agree to comply by said provisions.

[Signature]  
APPLICANT(S) SIGNATURE


\*\*\*\*\*

INSPECTOR TIM

Date inspected 9-11-92 Approved ✓ Rejected \_\_\_\_\_  
Reason for rejection \_\_\_\_\_

Date reinspected \_\_\_\_\_ Approved \_\_\_\_\_ Rejected \_\_\_\_\_

Notes:  
Size Pipe 6"  
Type Pipe SDR35  
Basement Yes \_\_\_\_\_ No ✓  
Sump Pump Yes \_\_\_\_\_ No ✓  
Downspout to Ground Yes ✓ No \_\_\_\_\_  
Septic Tank Pumped & filled Yes ✓ No \_\_\_\_\_  
Contractor HAIL MARK HOMES  
Special Conditions (Rov)

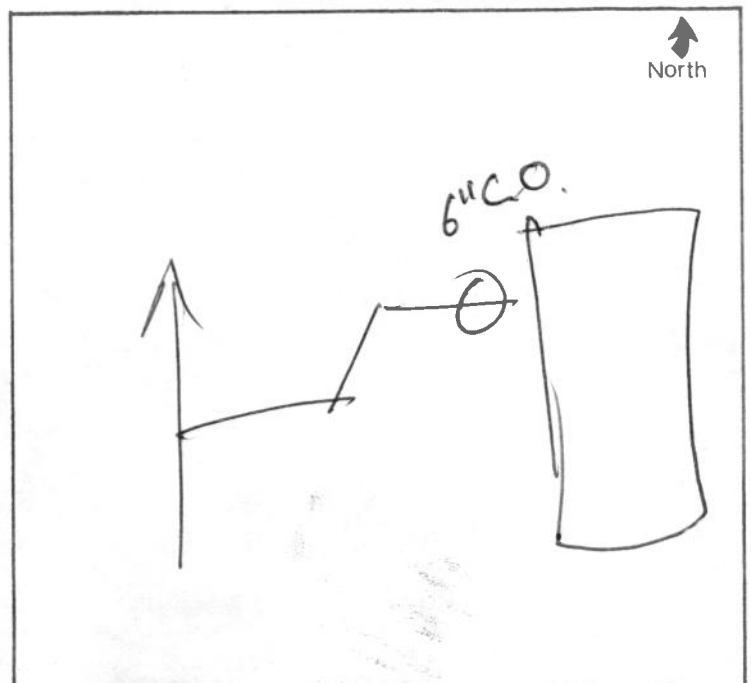

Old over on file

FALL CREEK REGIONAL WASTE DISTRICT

Box 24, Pendleton, Indiana 46054



Ref 25


No 001848

2/28/95  
Eric & Anne Perkins  
217 Jackson Highway  
Pendleton, IN 46054  
Phone: 700 00  
Fax: 700 00

Logistics...  
The following...  
I have...  
Sincerely,  
[Signature]

JIM

4-11-95

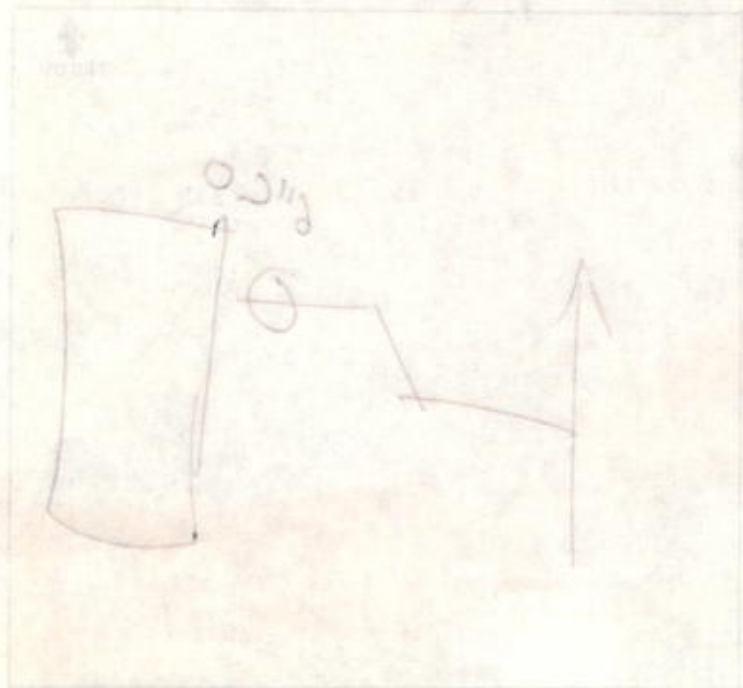

HAN MARK HONG  
(P.O.)