


Gidw.

PROJECT Phase II SHEET _____ OF _____
SUBJECT _____ DATE 6-27-18
JOB NO. 444-7
BY Atlas

217 Moore Ave

↑
N

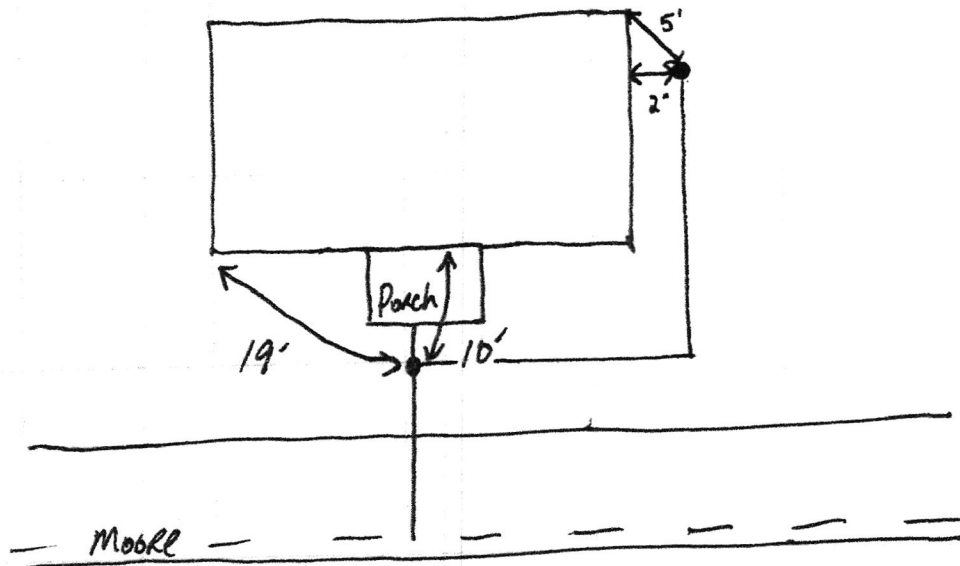

an more

Sgt Phase II

7-6-18



011 Moore

SPT Phase II

7.6.18

