

Gidw.

PROJECT Phase II SHEET _____ OF _____


SUBJECT _____ DATE 7-19-18

JOB NO. 4447

BY Atlas

217 S. Broadway

N →

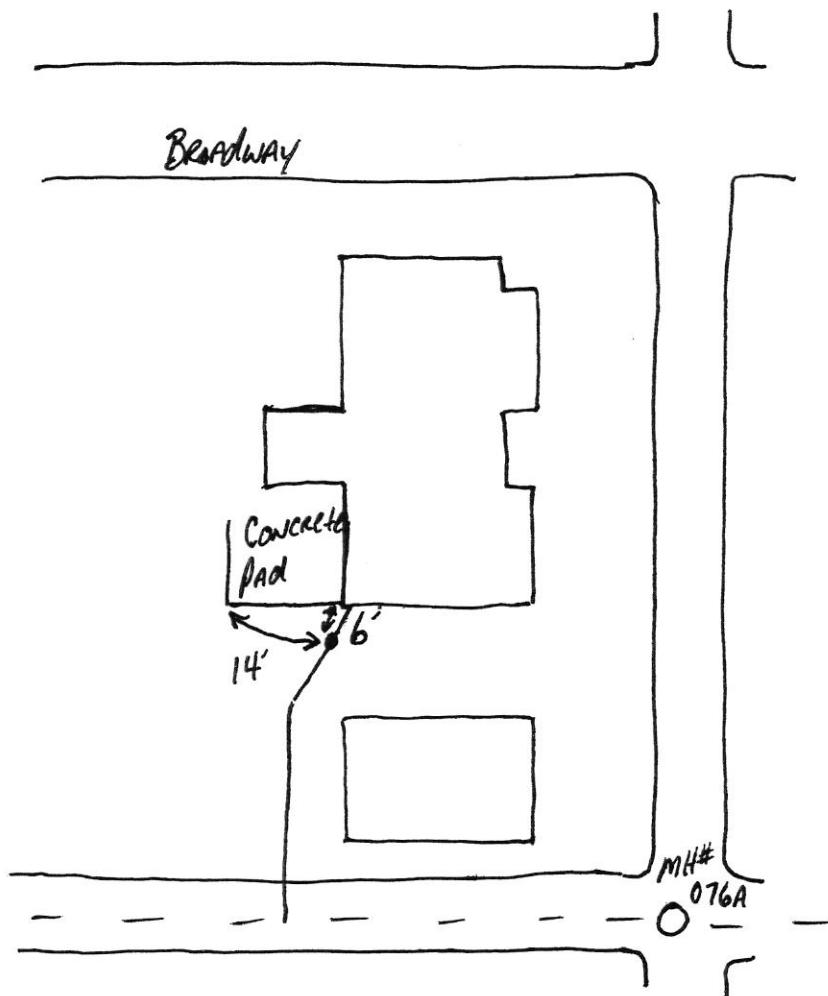

7.30.18

SRF Phase II

an S Broadway

