



FALL CREEK REGIONAL WASTE DISTRICT

9378 S. 650 West PO Box 59  
Pendleton, IN 46064-0059 778-7544

3-08109.02

APPLICATION FOR SEWER PERMIT

Nº 2397

Date 8/13/94

Permit Void 90 days from Date of Issuance

Owner Name Ira Bronner

Property Address 217 Broadway

Lot # \_\_\_\_\_ P.O. Box \_\_\_\_\_

Town Pendleton, IN Zip Code 46064

Phone \_\_\_\_\_ City Water ☒ Well \_\_\_\_\_

\$ N/A Tap on Fee Paid \_\_\_\_\_

\$ N/A Inspection fee paid \_\_\_\_\_

Lateral Replacement

Application is hereby made for connection to the Fall Creek Regional Waste District Sewer System for the above listed property - Permit Type: Residential ☒, Commercial \_\_\_\_\_, Industrial \_\_\_\_\_, or Governmental/Institutional \_\_\_\_\_. User Information \_\_\_\_\_.

All workmanship and materials shall conform to the standards of the District Ordinance as described in Ordinance 84-2 and 84-3 as amended. Acceptance and approval must be made by the District inspector or his duly authorized representative before backfilling and final connection is made to the main sewer lines. Any violation of applicable regulations will cause all lines and appurtenances in violation to be removed and replaced at the owners expense.

The Fall Creek Regional Waste District is responsible for the inspection, approval of materials, and installation techniques only. All costs for materials and installation and any liabilities resulting from same is the sole responsibility of the property owner.

I have read and fully understand the above provisions and agree to comply by said provisions.

APPLICANT(S) SIGNATURE

\*\*\*\*\*

INSPECTOR DAI

Date inspected 8/13/94 Approved ☒ Rejected \_\_\_\_\_

Reason for rejection \_\_\_\_\_

Date reinspected \_\_\_\_\_ Approved \_\_\_\_\_ Rejected \_\_\_\_\_

Notes:

Size Pipe 4 "

Type Pipe PVC

Basement Yes \_\_\_\_\_ No \_\_\_\_\_

Sump Pump Yes \_\_\_\_\_ No \_\_\_\_\_

Downspout to Ground Yes \_\_\_\_\_ No \_\_\_\_\_


Septic Tank Pumped & filled Yes \_\_\_\_\_ No \_\_\_\_\_

Contractor EARL DAVIS

Special Conditions \_\_\_\_\_

Existing Home \_\_\_\_\_

New Construction \_\_\_\_\_

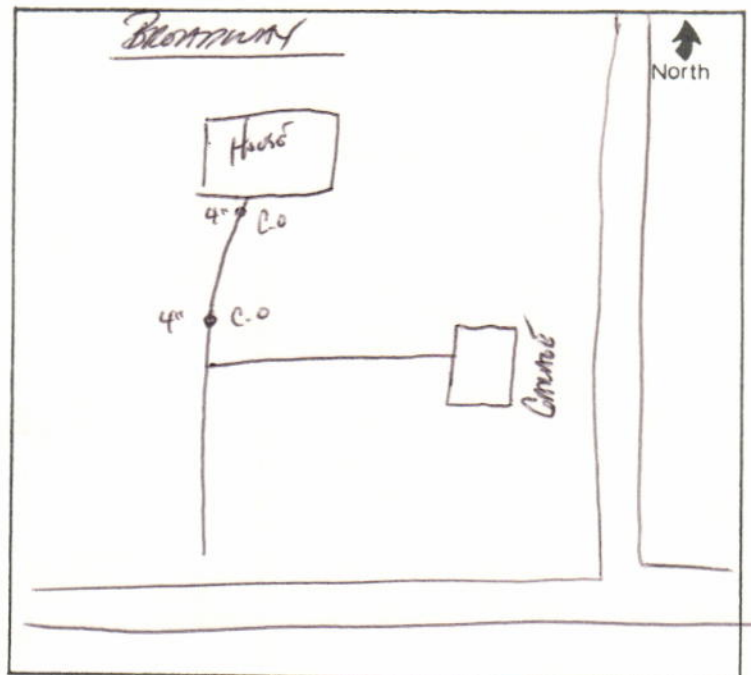

*GRW.*

PROJECT Phase II SHEET \_\_\_\_\_ OF \_\_\_\_\_


SUBJECT \_\_\_\_\_ DATE 7-19-18

JOB NO. 4447

BY Atlas

217 S. Broadway

N →

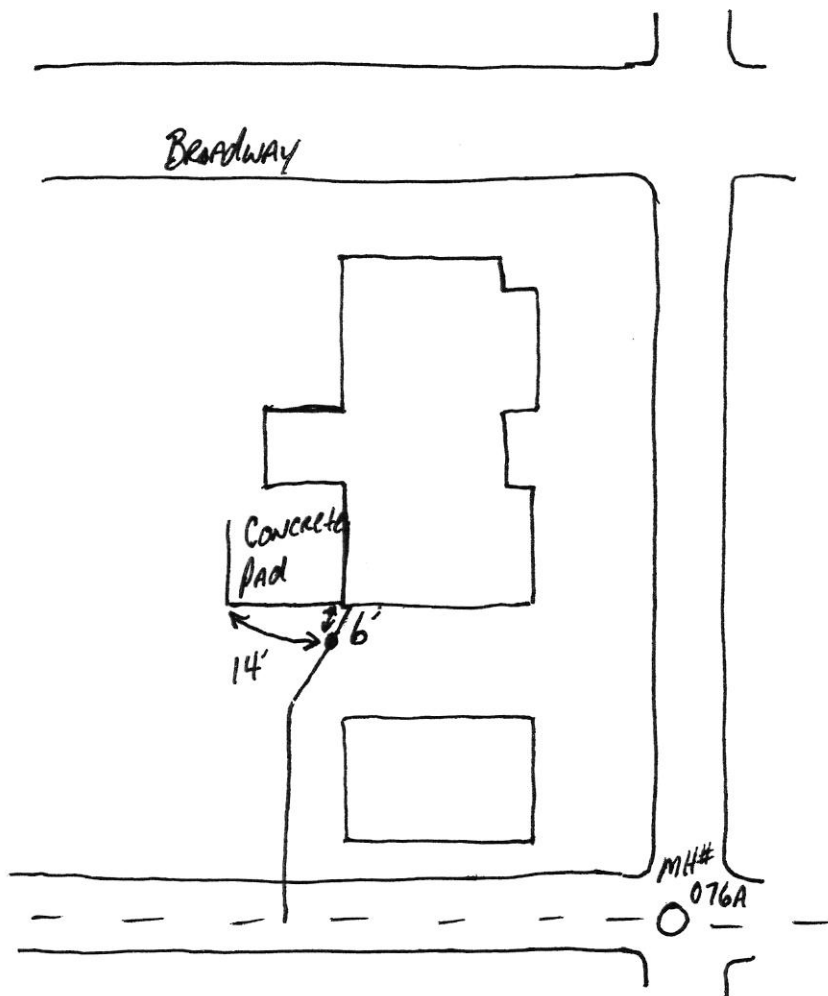



7.30.18

SRF Phase II

an S Broadway

