


Gidw.

PROJECT Phase II SHEET _____ OF _____

SUBJECT _____ DATE 3-14-18

JOB NO. 4447

BY Atlas

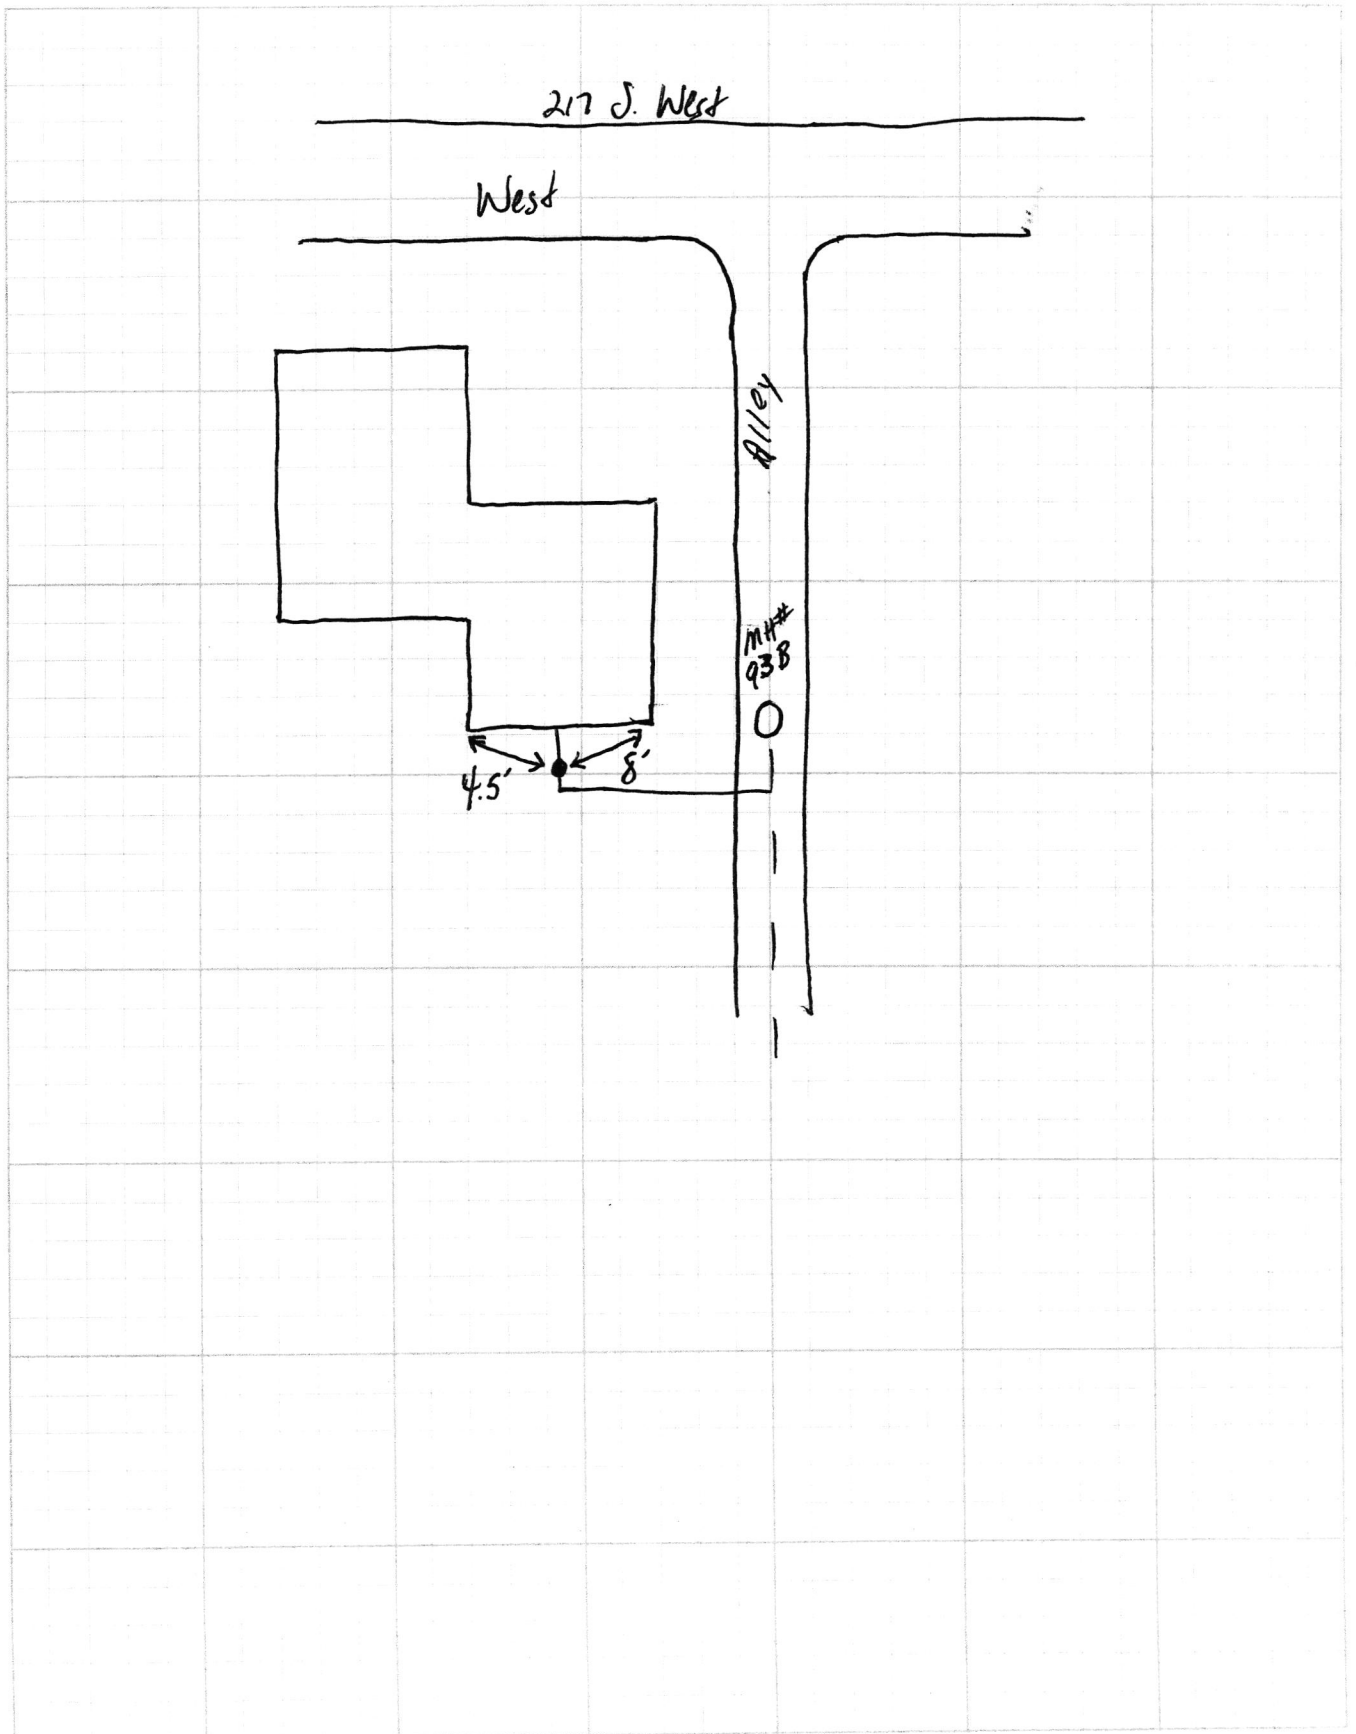

217 S West ST

SRP Phase II

