

G.R.W.

PROJECT Phase II SHEET _____ OF _____

SUBJECT _____ DATE 4-12-18


JOB NO. 4447

BY Atlas

217 W. High



Left existing 4" PVC in place

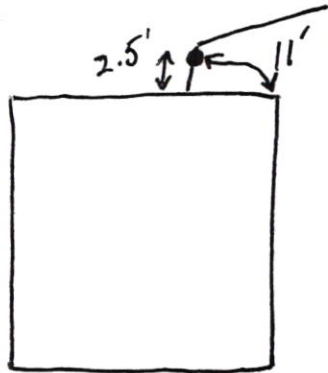

High

○ MH# 93

217 w High

SRF
Phase II

4.20.18

