


Gidw.

PROJECT Phase II SHEET _____ OF _____

SUBJECT _____ DATE 6-25-18

JOB NO. 4447

BY Atlas

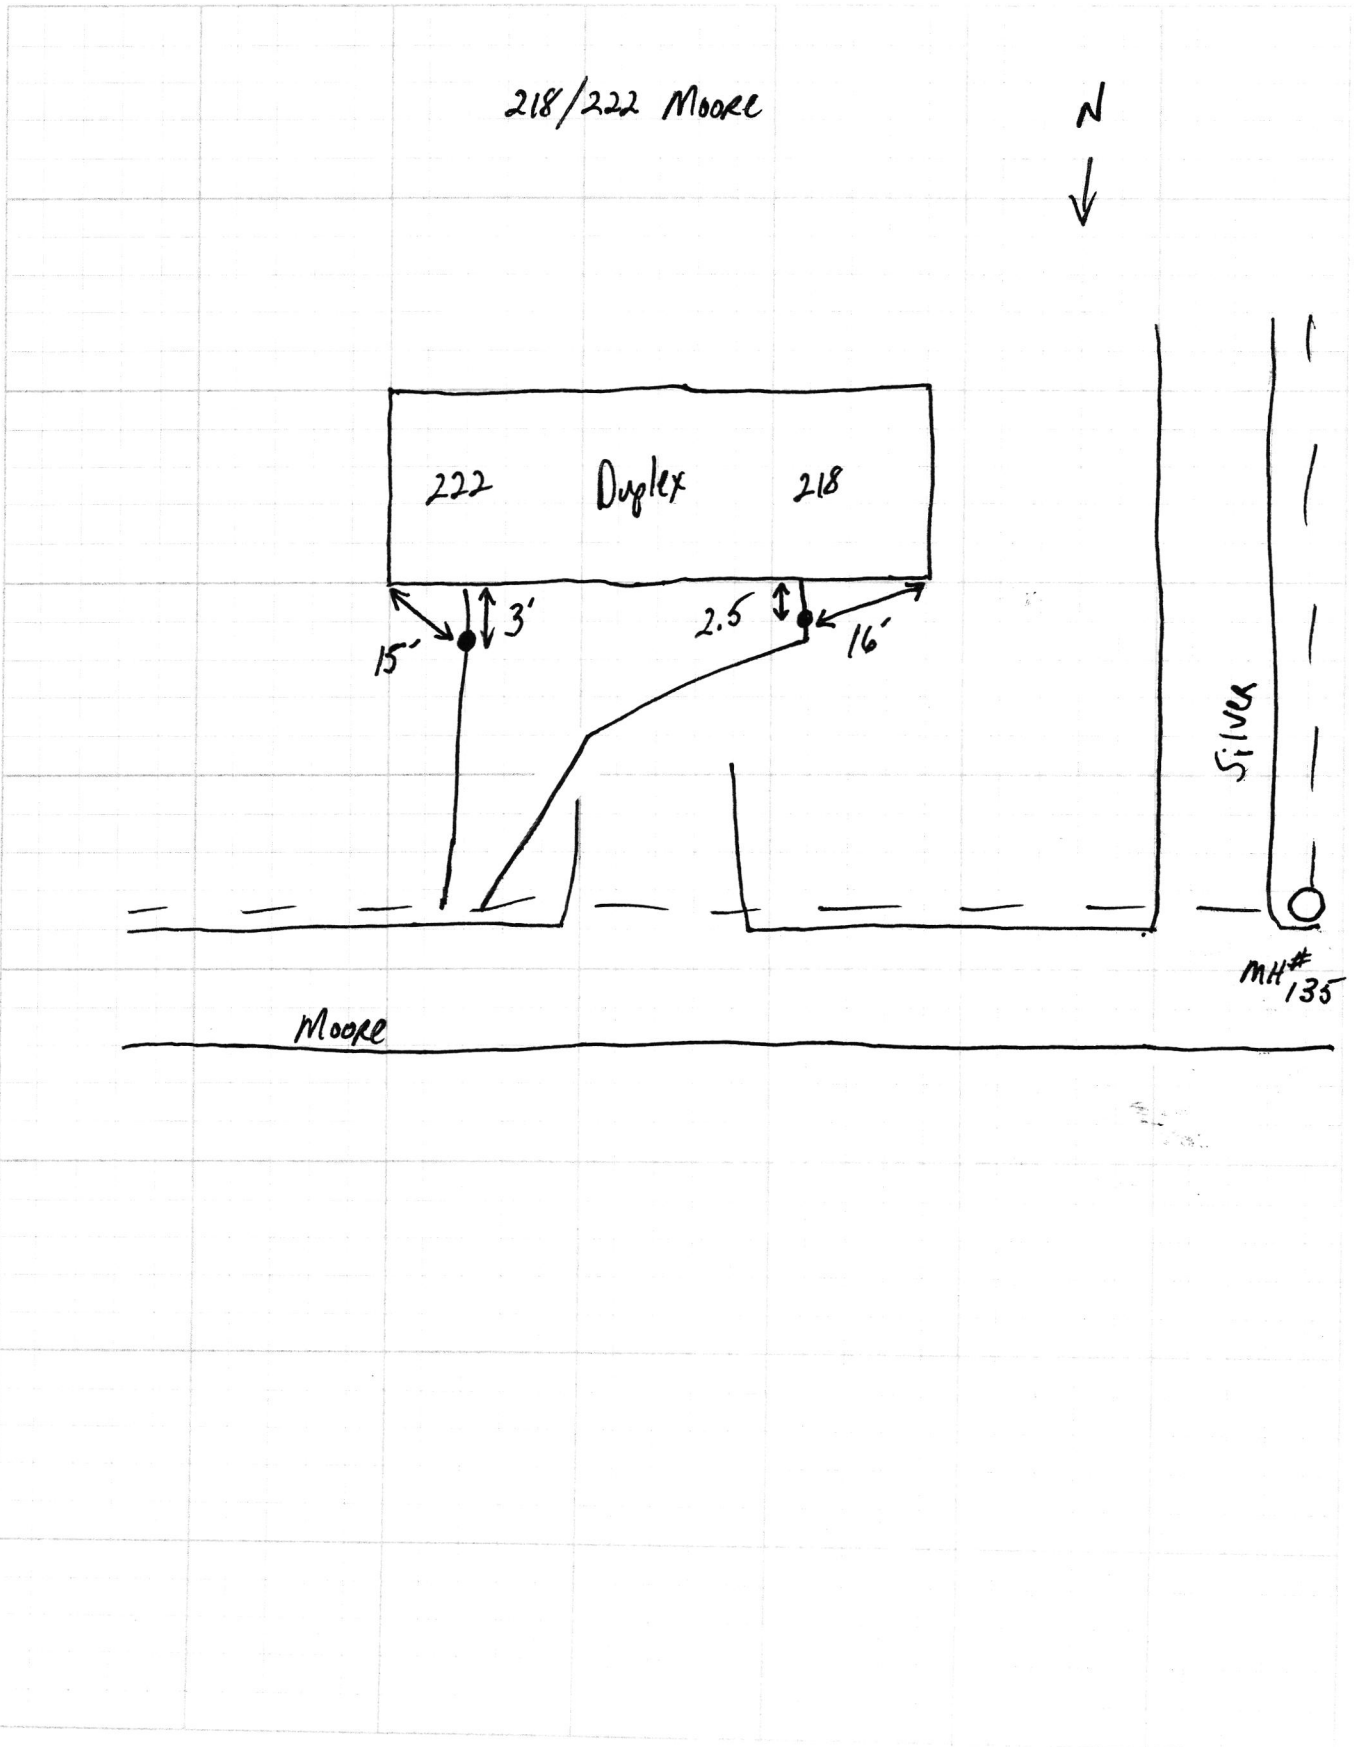

218 Moore

Sgt Phase II

6.25.18



218 Moore

SRP Phase II

7.6.18



aaa Moore

SAP Phase II

7.6.18

