




PROJECT Phase II SHEET _____ OF _____

SUBJECT _____ DATE 4-19-18

JOB NO. 4447

BY Atlas

218 E. Madison

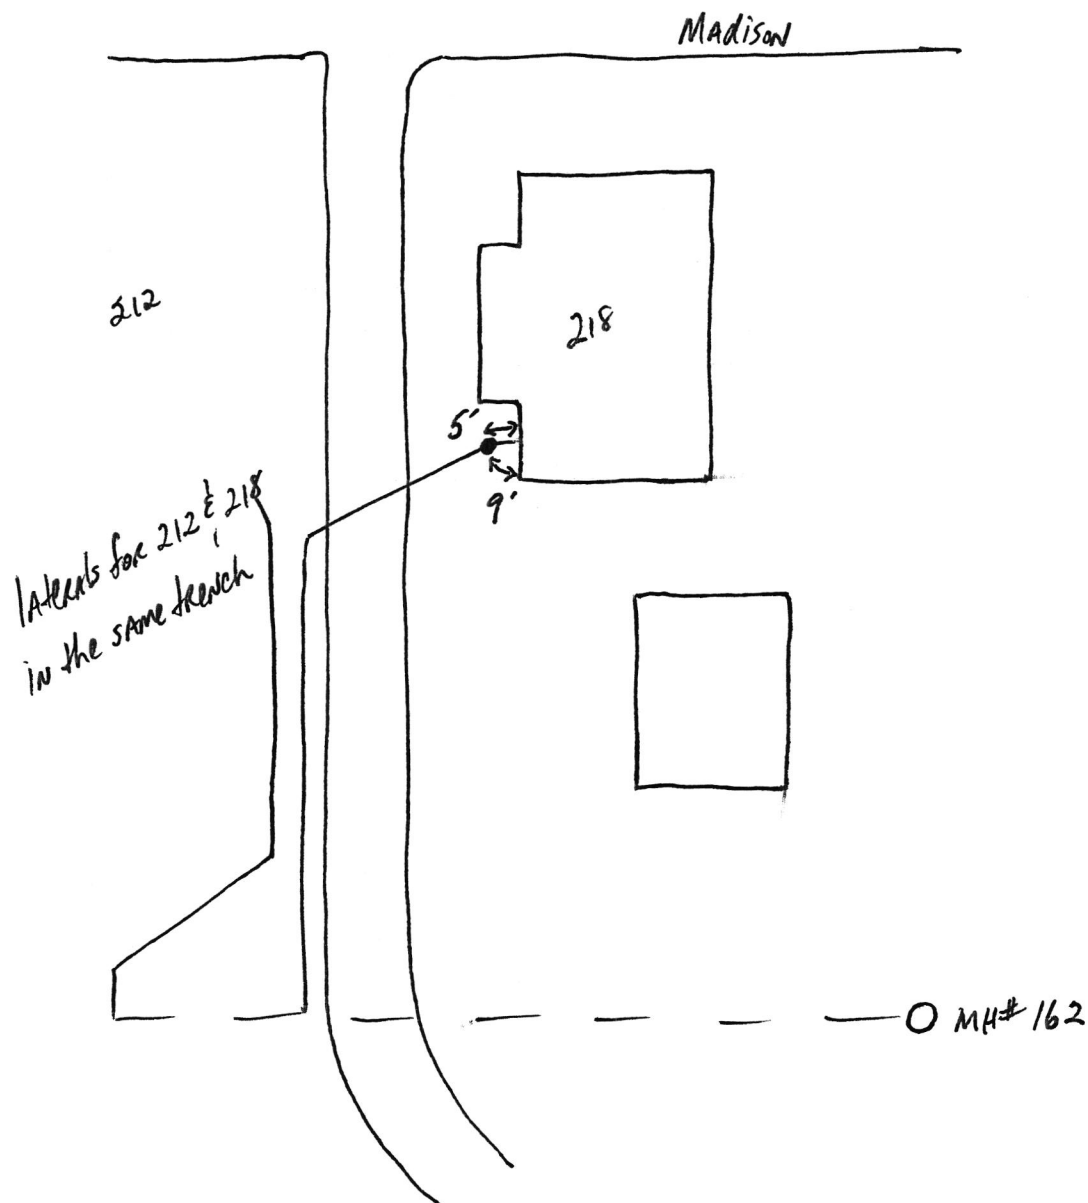

218 E Madison

SRF
Phase II

5.3.18

