

G.R.W.

PROJECT

Phase II

SHEET

OF

SUBJECT

DATE

7-16-18

JOB NO.


4447

BY

Atlas

218 E. State

↑
N

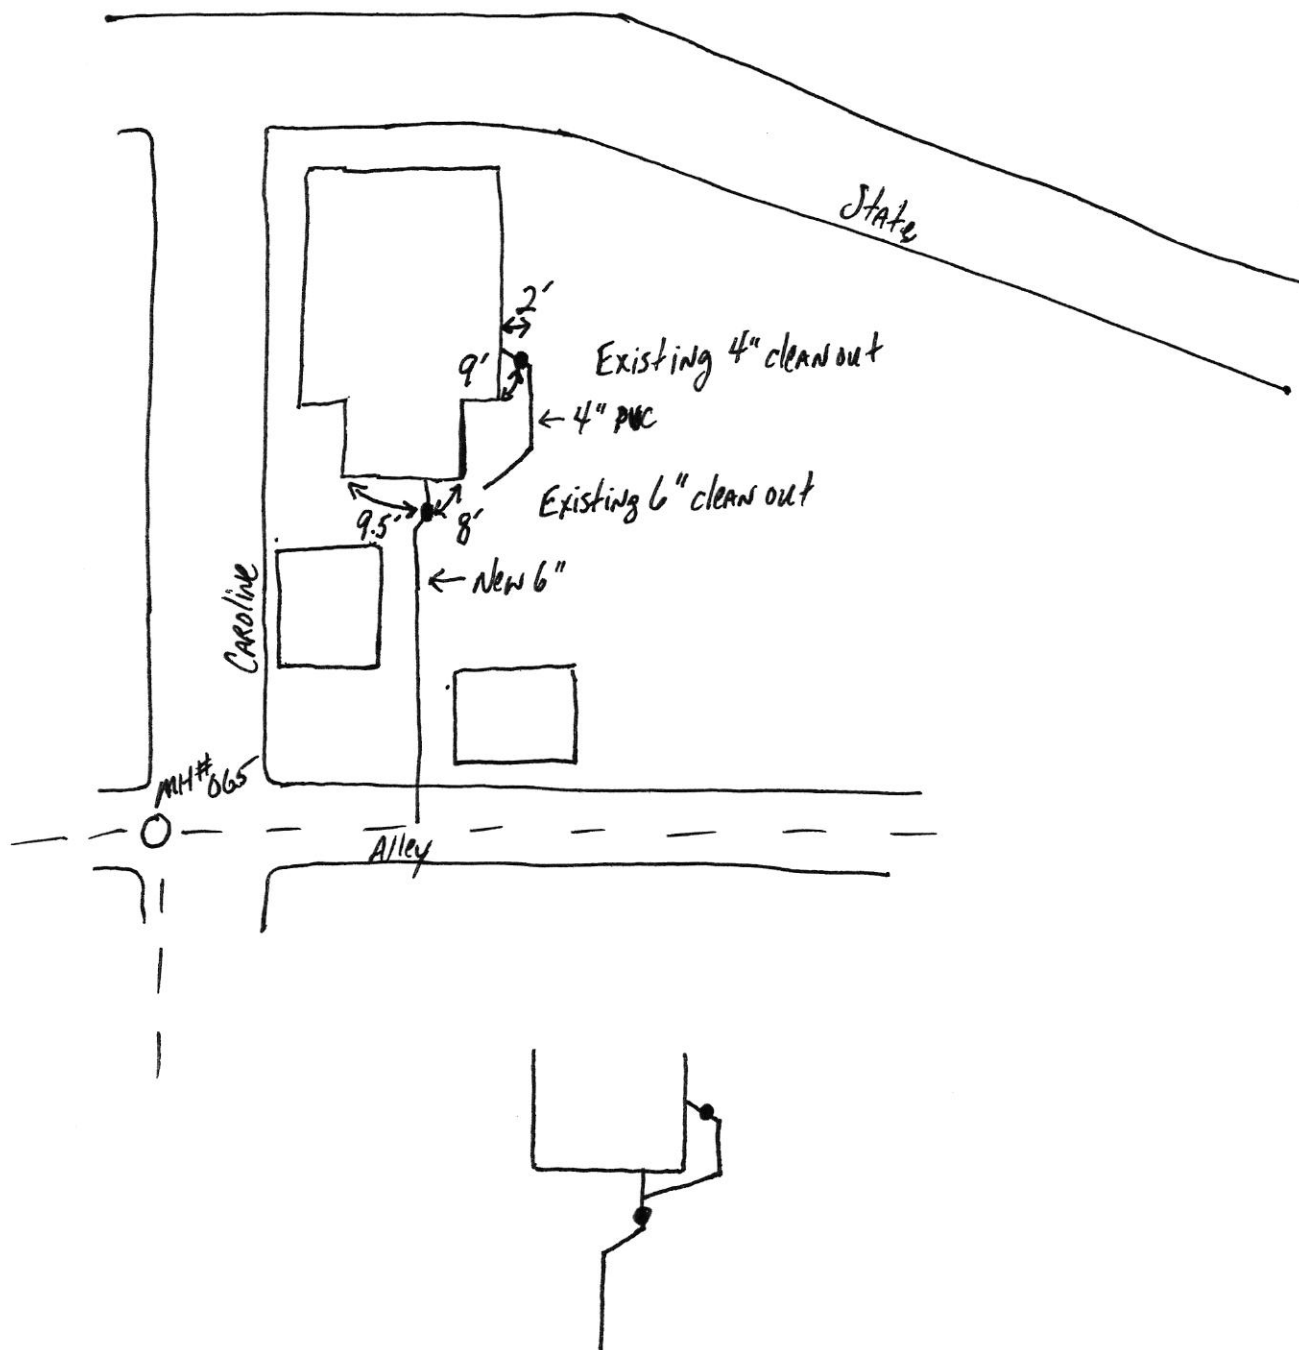

218 E State

SHP Phase II

7.18.18





218 2 spot ST

Sgt Phase II

7.18.18