

Gidw.

PROJECT

Phase II

SHEET

OF

SUBJECT

DATE

7-5-18

JOB NO.

4447


BY

AJ/AS

218 J. East

← N

East

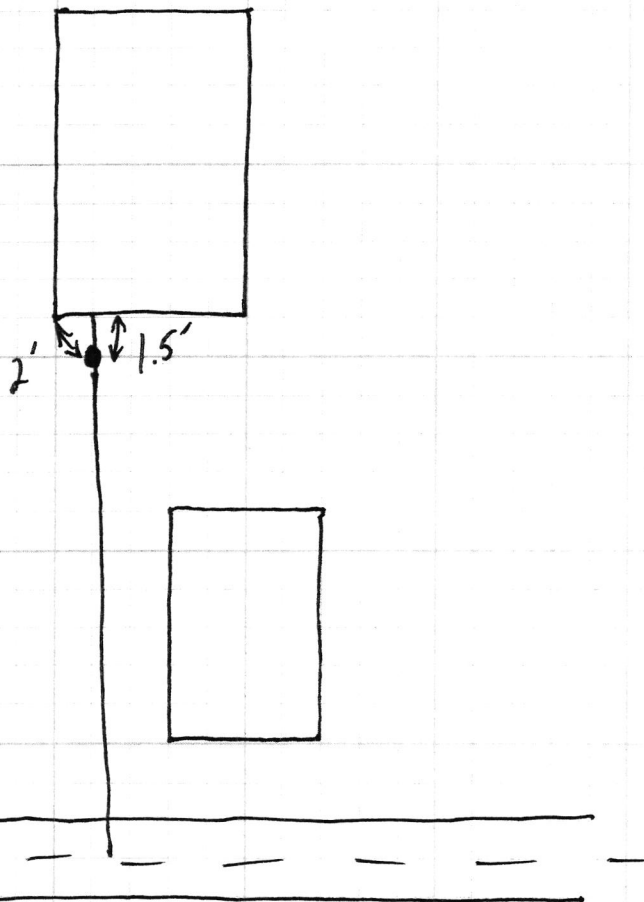



218 East

SRF Phase II

7.6.18

