

Gidw.

PROJECT Phase II SHEET _____ OF _____


SUBJECT _____ DATE 3-26-18

JOB NO. 4447

BY Atlas

218 S. West

West

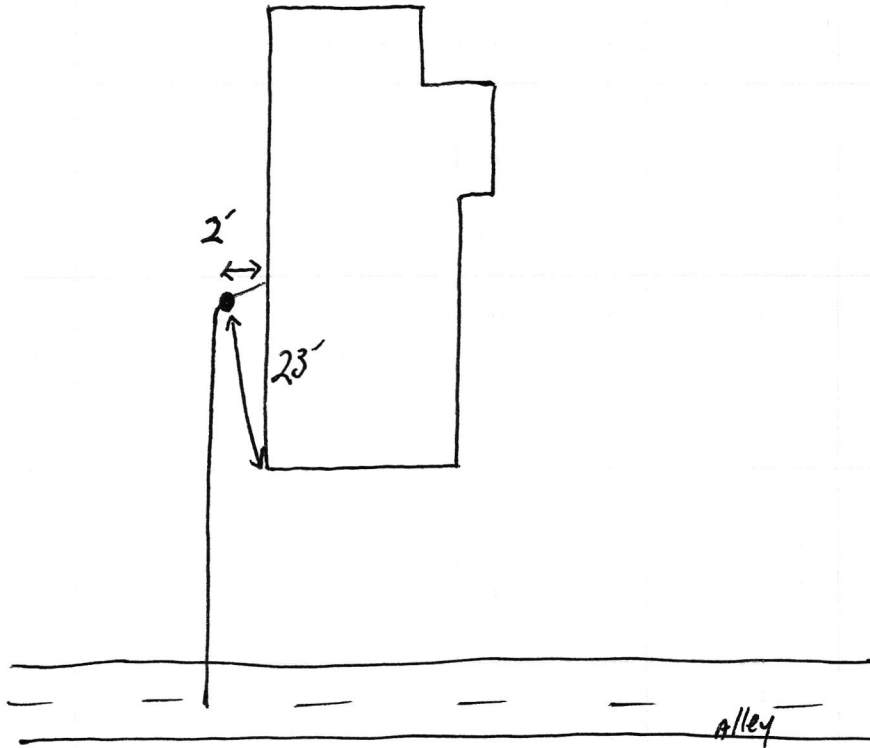

218 S West

SRF Phase II

