


PROJECT Phase II SHEET _____ OF _____
SUBJECT _____ DATE 2-9-18
JOB NO. 4447
BY A/HAS

218 W. TAYLOR

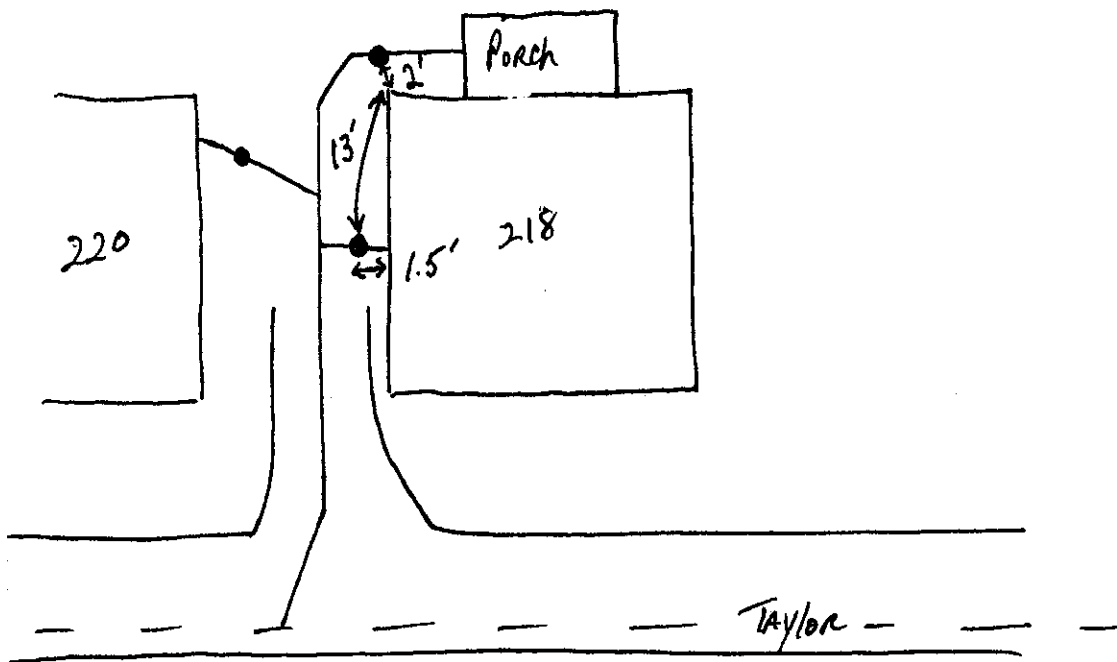

218 W Taylor

SRF Phase II

2.9.18

