

Gidw.

PROJECT Phase II SHEET _____ OF _____


SUBJECT _____ DATE 7-19-18

JOB NO. 4447

BY Atlas

219 E. High

← N

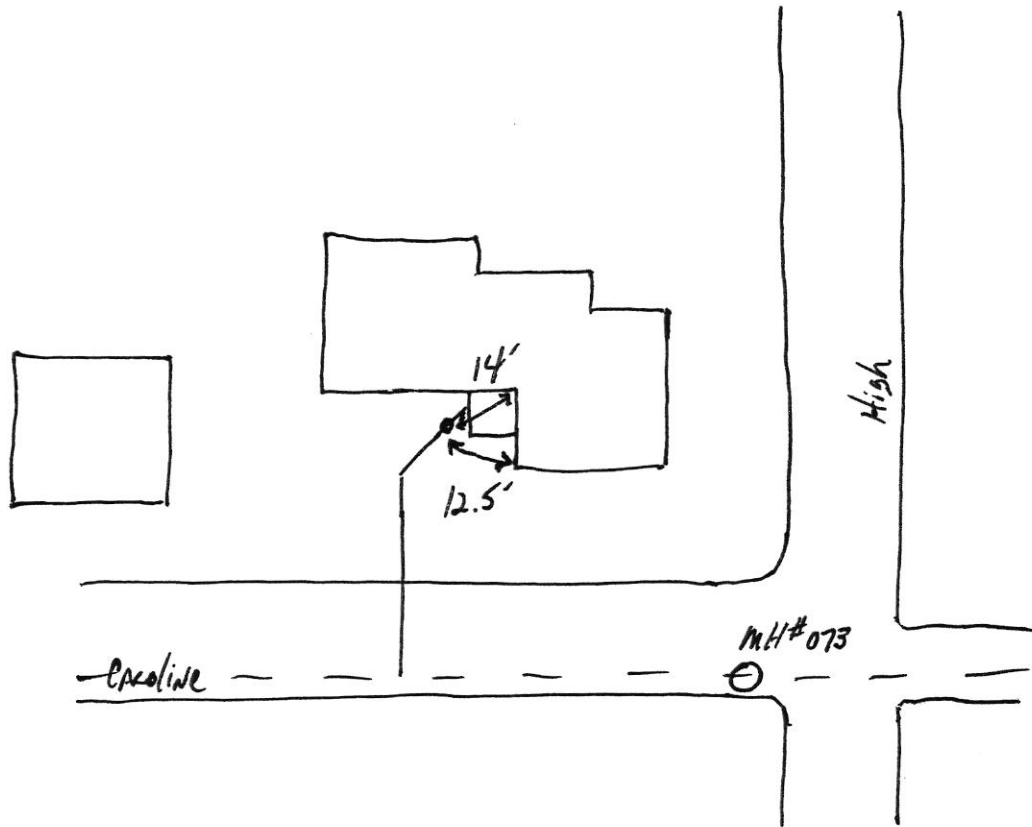

air E High

SAC Phase II

7.30.18

