

Gidw.

PROJECT

Phase II

SHEET

OF

SUBJECT

DATE

7-9-12

JOB NO.

4447


BY

Atlas

219 S. Pearl

N →

Pearl

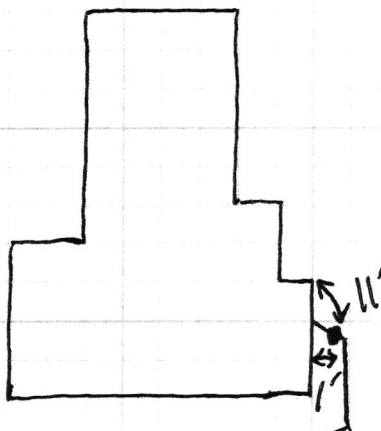

Alley

214 Year-1

SAP Phase II

7.11.18

