


Gidw.

PROJECT Phase II SHEET _____ OF _____
SUBJECT _____ DATE 2-7-18
JOB NO. 4447
BY Atlas

219 W. Taylor

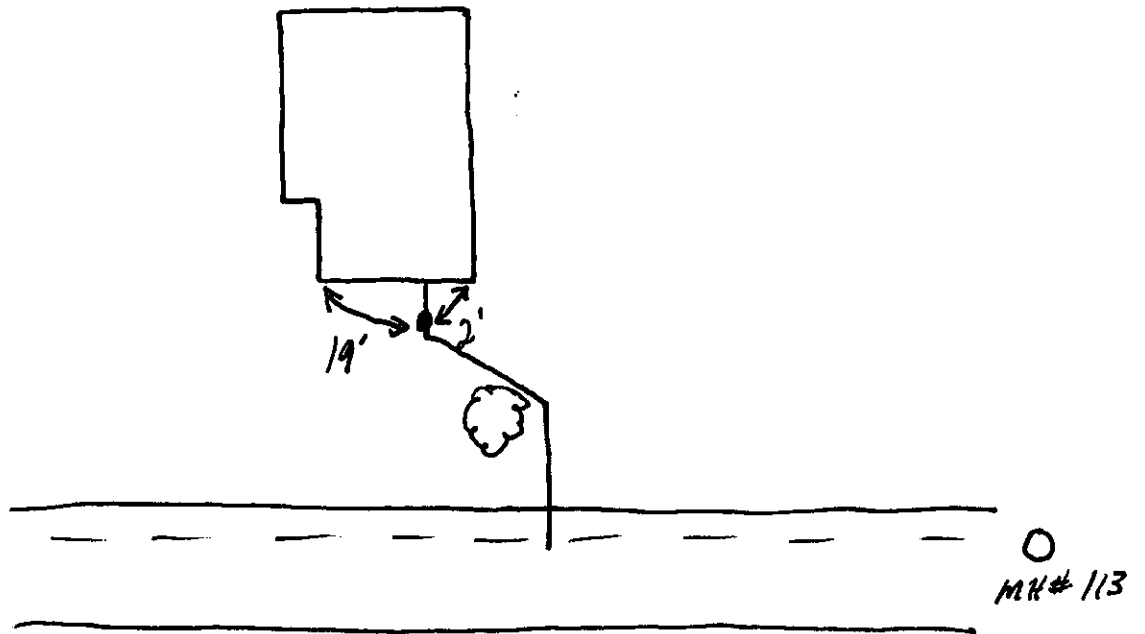

219 W Taylor

SRF Phase II

2.7.18

