

Gidw.

PROJECT Phase IV SHEET _____ OF _____


SUBJECT _____ DATE 6-18-18

JOB NO. 4447

BY Atlas

220 E. Clark

← N

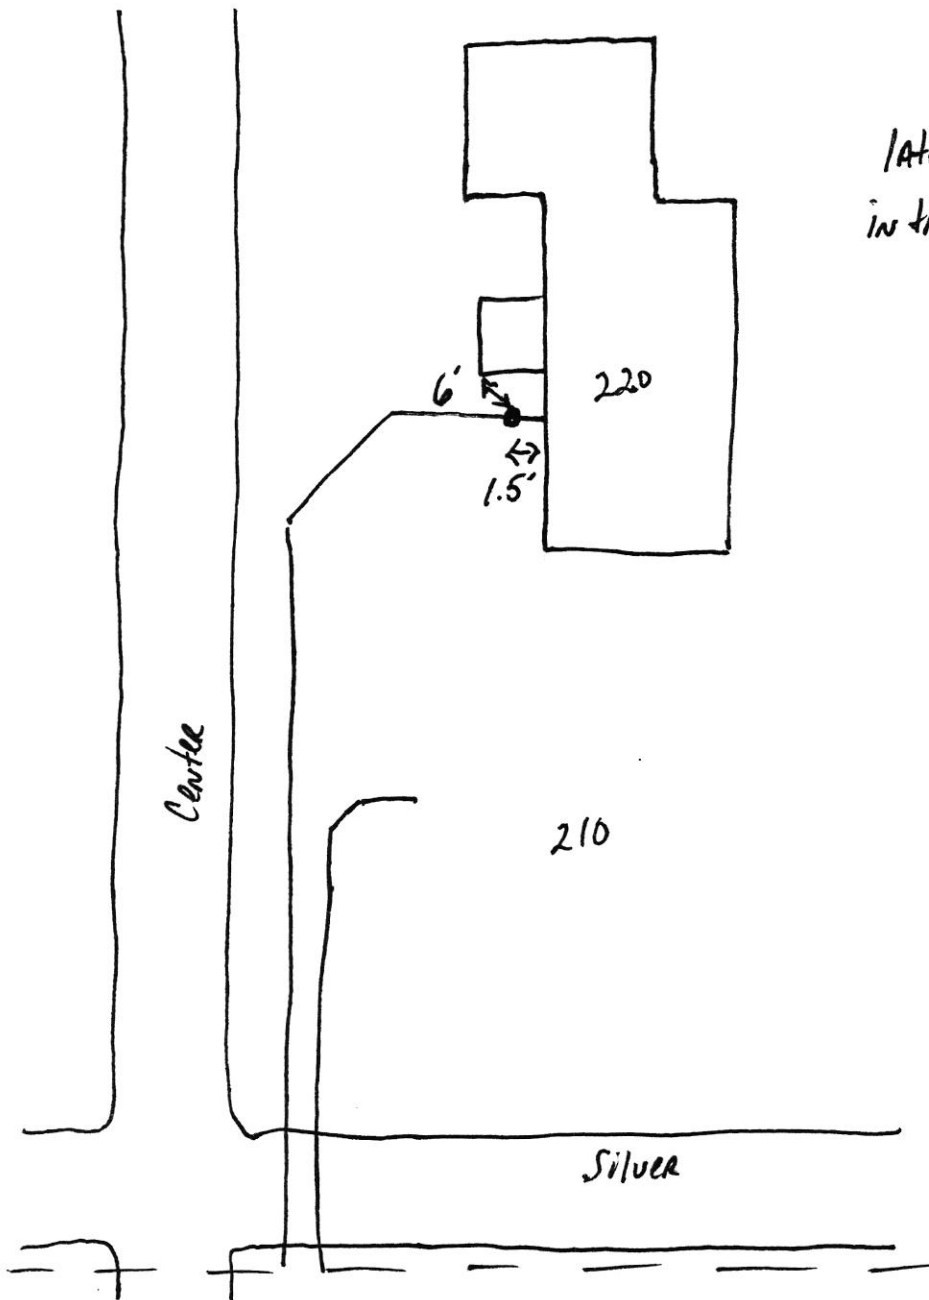

laterals for 220 & 210
in the same trench



and Clarke

SRP Phase II

08.19.18