

Gidw.



PROJECT Phase II SHEET \_\_\_\_\_ OF \_\_\_\_\_

SUBJECT \_\_\_\_\_ DATE 4-25-18

JOB NO. 4447

BY Atlas

220 E Madison

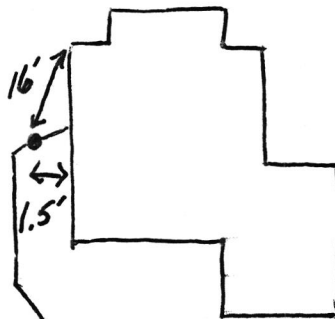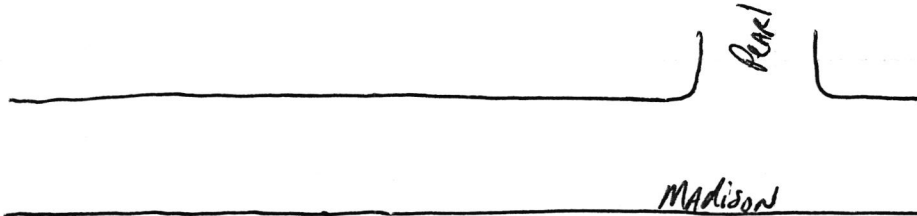

0  
MH#  
162

lateral for 304, 308, 312, 324 Madison

220 Madison

SRF  
Phase II

5.3.18

