

Gidw.


PROJECT Phase II- SHEET _____ OF _____

SUBJECT _____ DATE 4-9-18

JOB NO. 4447

BY Atlas

220 J. Jefferson

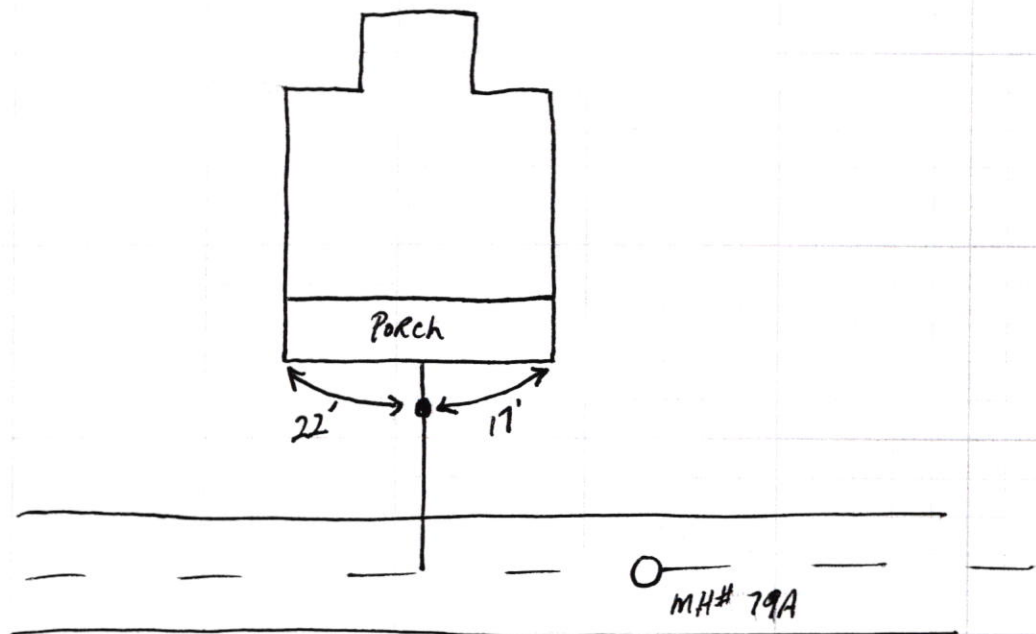

220 S Jefferson

SRF
Phase II

4.11.18

