


Gidw.

PROJECT Phase II SHEET \_\_\_\_\_ OF \_\_\_\_\_  
SUBJECT \_\_\_\_\_ DATE 3-23-18  
JOB NO. 4444  
BY Atlas

220 S. Adams

Adams

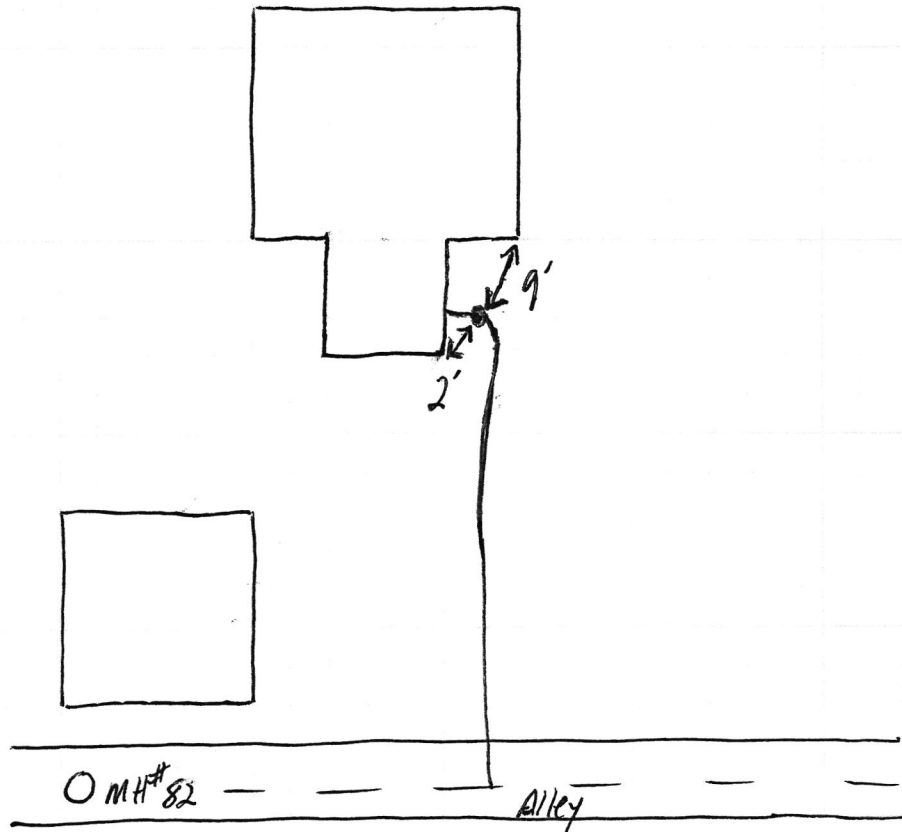

220 S Adams

SRF Phase II

