


Gidw.

PROJECT Phase II SHEET _____ OF _____
SUBJECT _____ DATE 2-12-18
JOB NO. 4647
BY At/As

220 W. Taylor

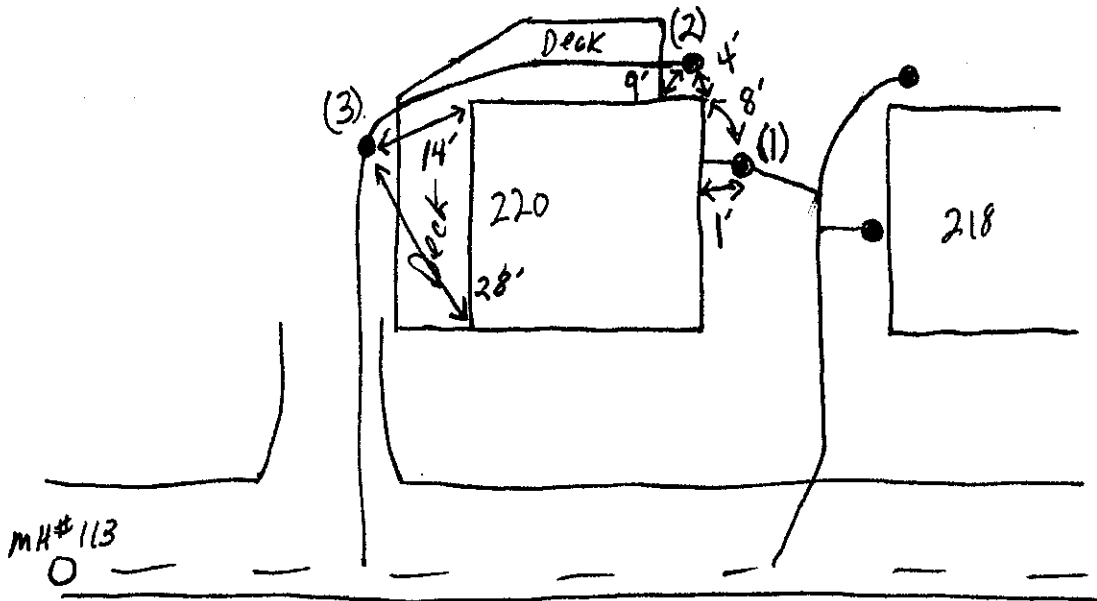

220 W. Taylor ties into 218 on the east side
of the house (clean out no. 1)

It is believed there is also a lateral coming
out the north side of the house between
clean out no. 2 & 3 - could not be verified -
the pipe between 2 & 3 is clayfield tile and
under the deck.

220 W Taylor

SRF Phase II

2.12.18



220 W Taylor

SRF Phase II

2.12.18



220 W Taylor

SRF Phase II

2-12-18

