

Gidw.

PROJECT Phase II SHEET _____ OF _____


SUBJECT _____ DATE 4-10-18

JOB NO. 4447

BY Atlas

221 1/2 S. West

Apt. behind 221 S. West

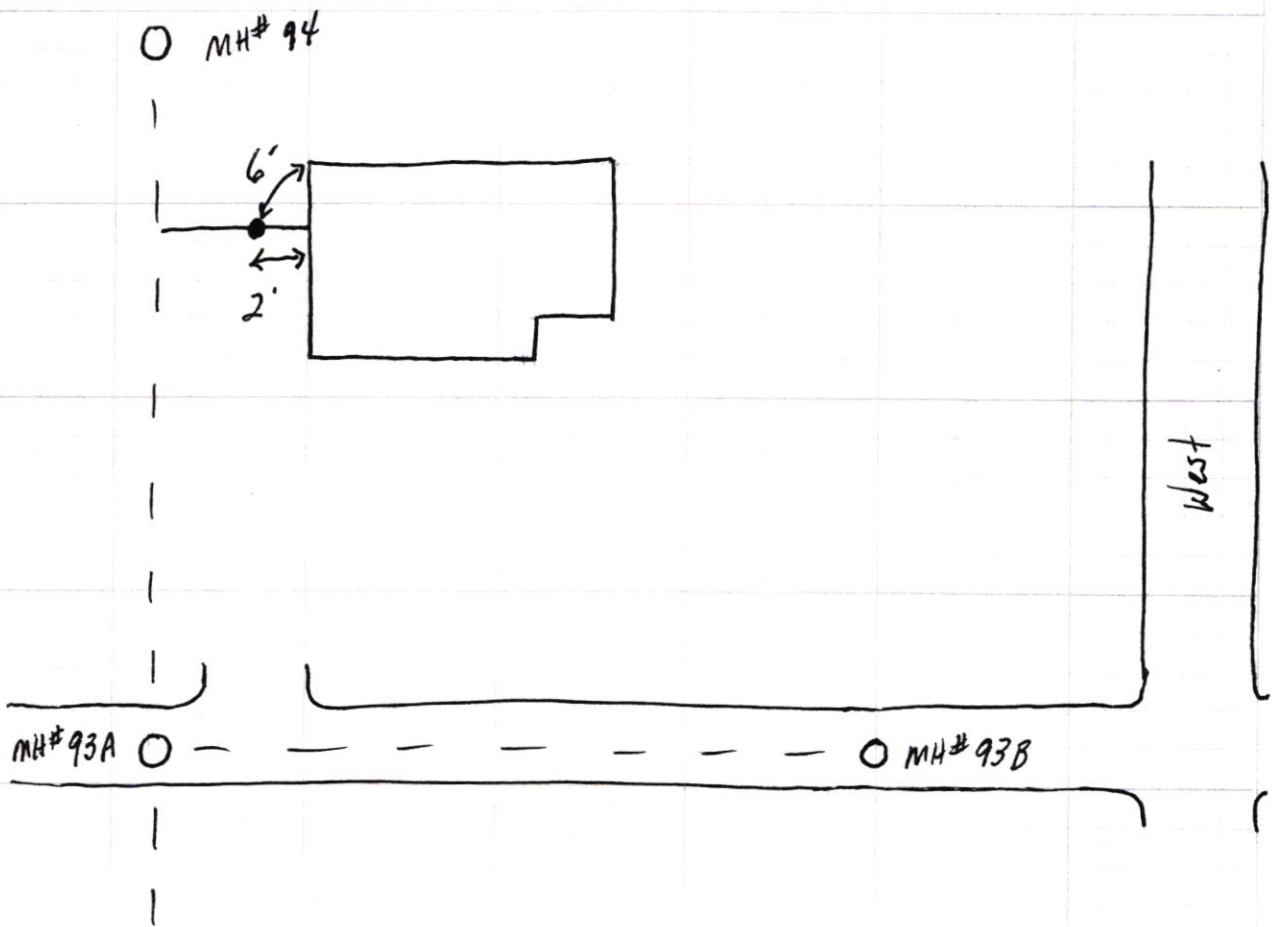

221 1/2 S West

SRP
Phase II

4.11.18

