

Gidw.


PROJECT Phase II SHEET _____ OF _____

SUBJECT _____ DATE 4-5-18

JOB NO. 4447

BY Atlas

221 Franklin

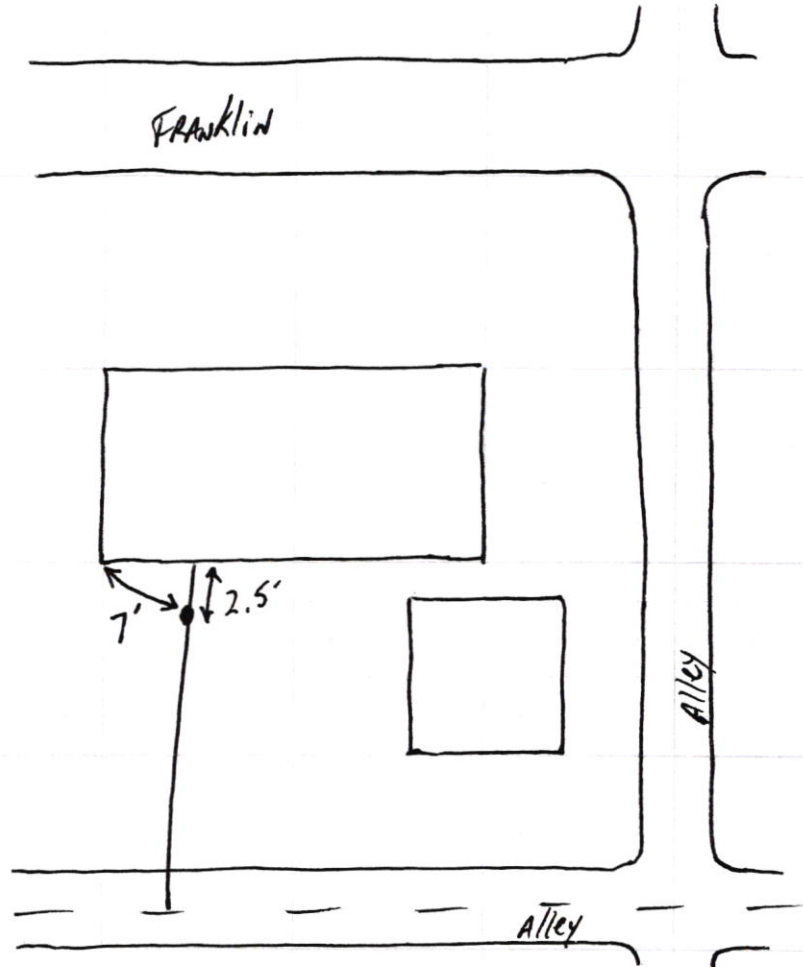

221 Franklin
331 High
325 High

SRP Phase II

Tim McCreedy
4.9.18



221 Franklin

SRF
Phase II

4.11.18

