


Gidw.

PROJECT Phase II SHEET _____ OF _____

SUBJECT _____ DATE 3-12-18

JOB NO. 4447

BY Atlas

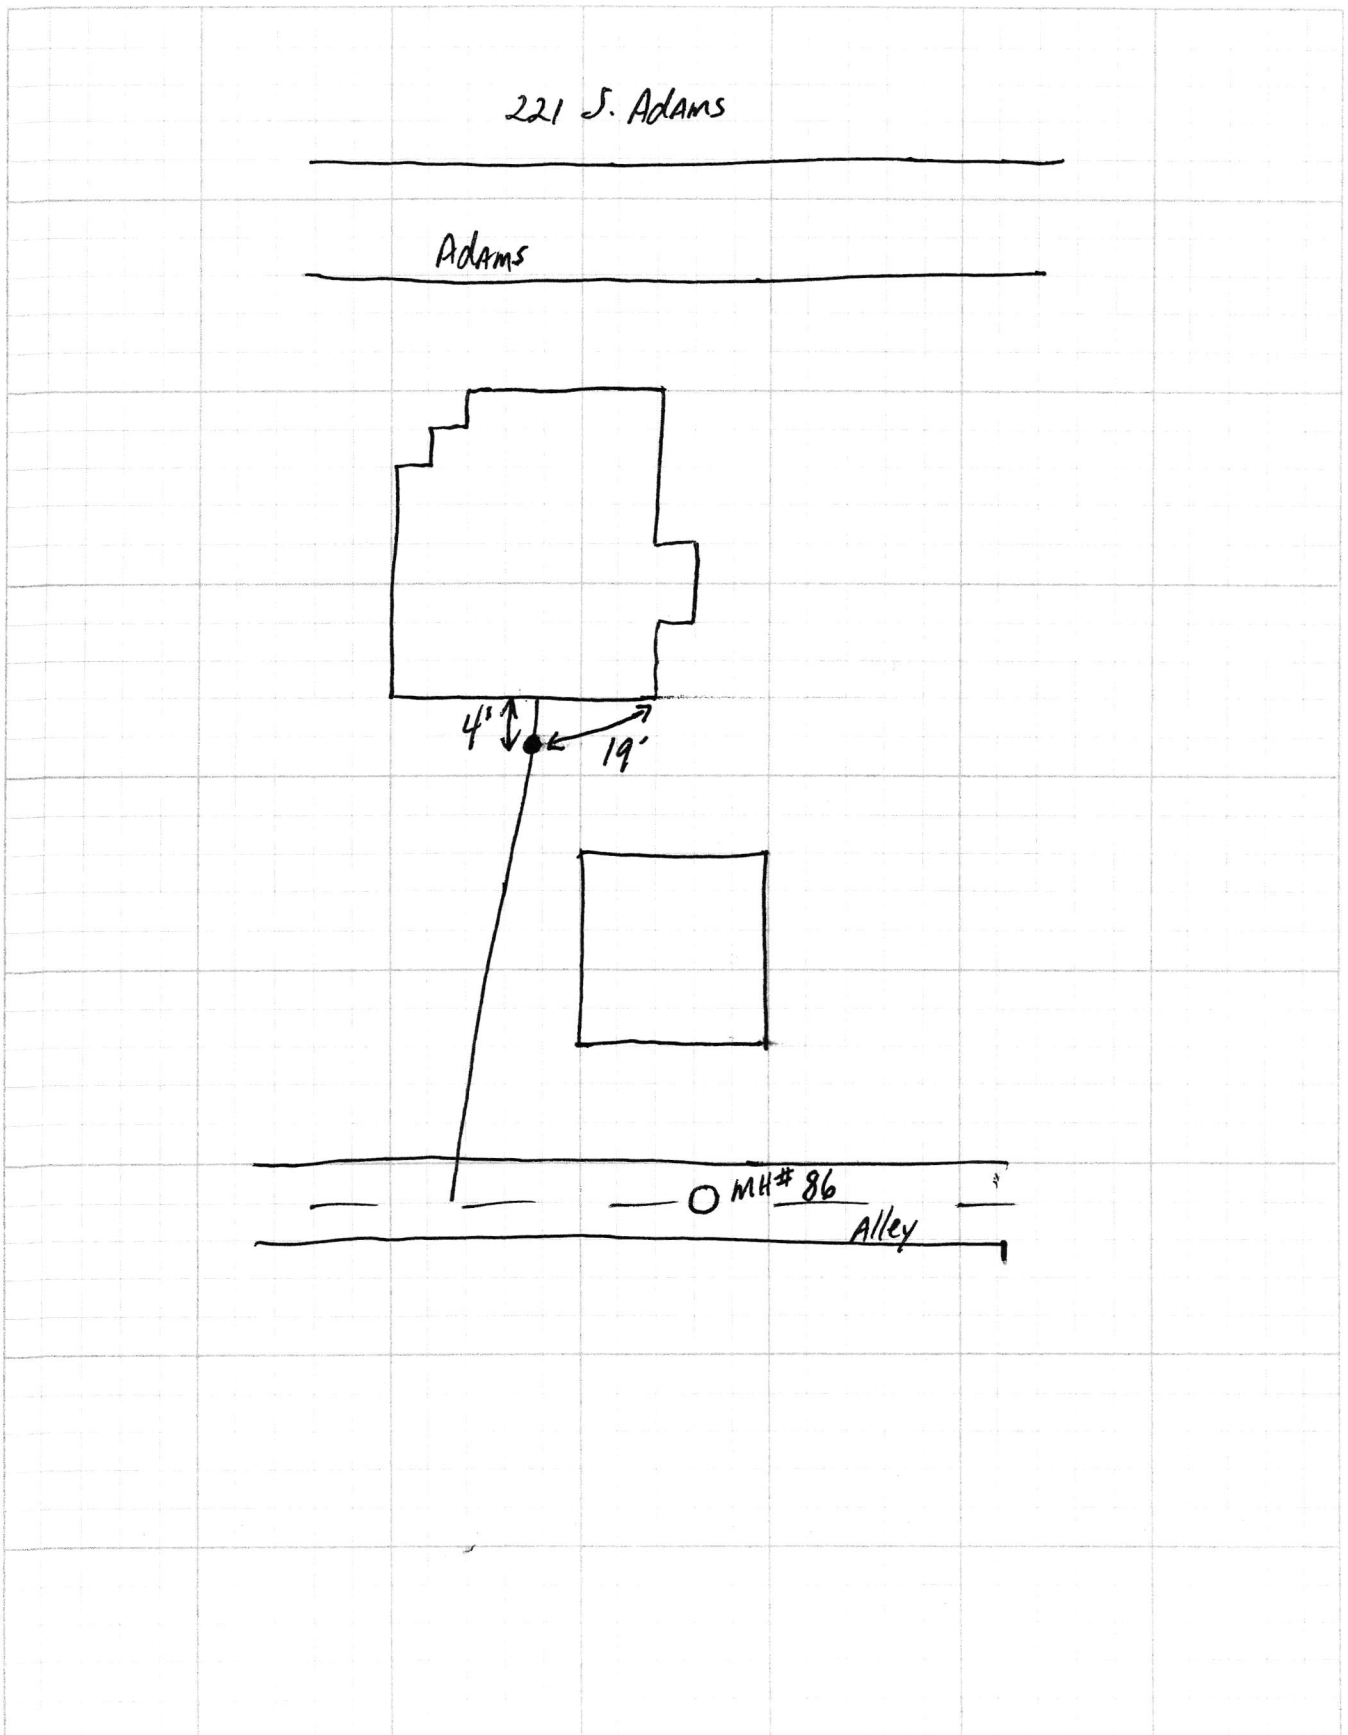

201 S Adams

SF Phase II

