


GRW.

PROJECT Phase II SHEET _____ OF _____

SUBJECT _____ DATE _____

JOB NO. 4447

BY FCRND

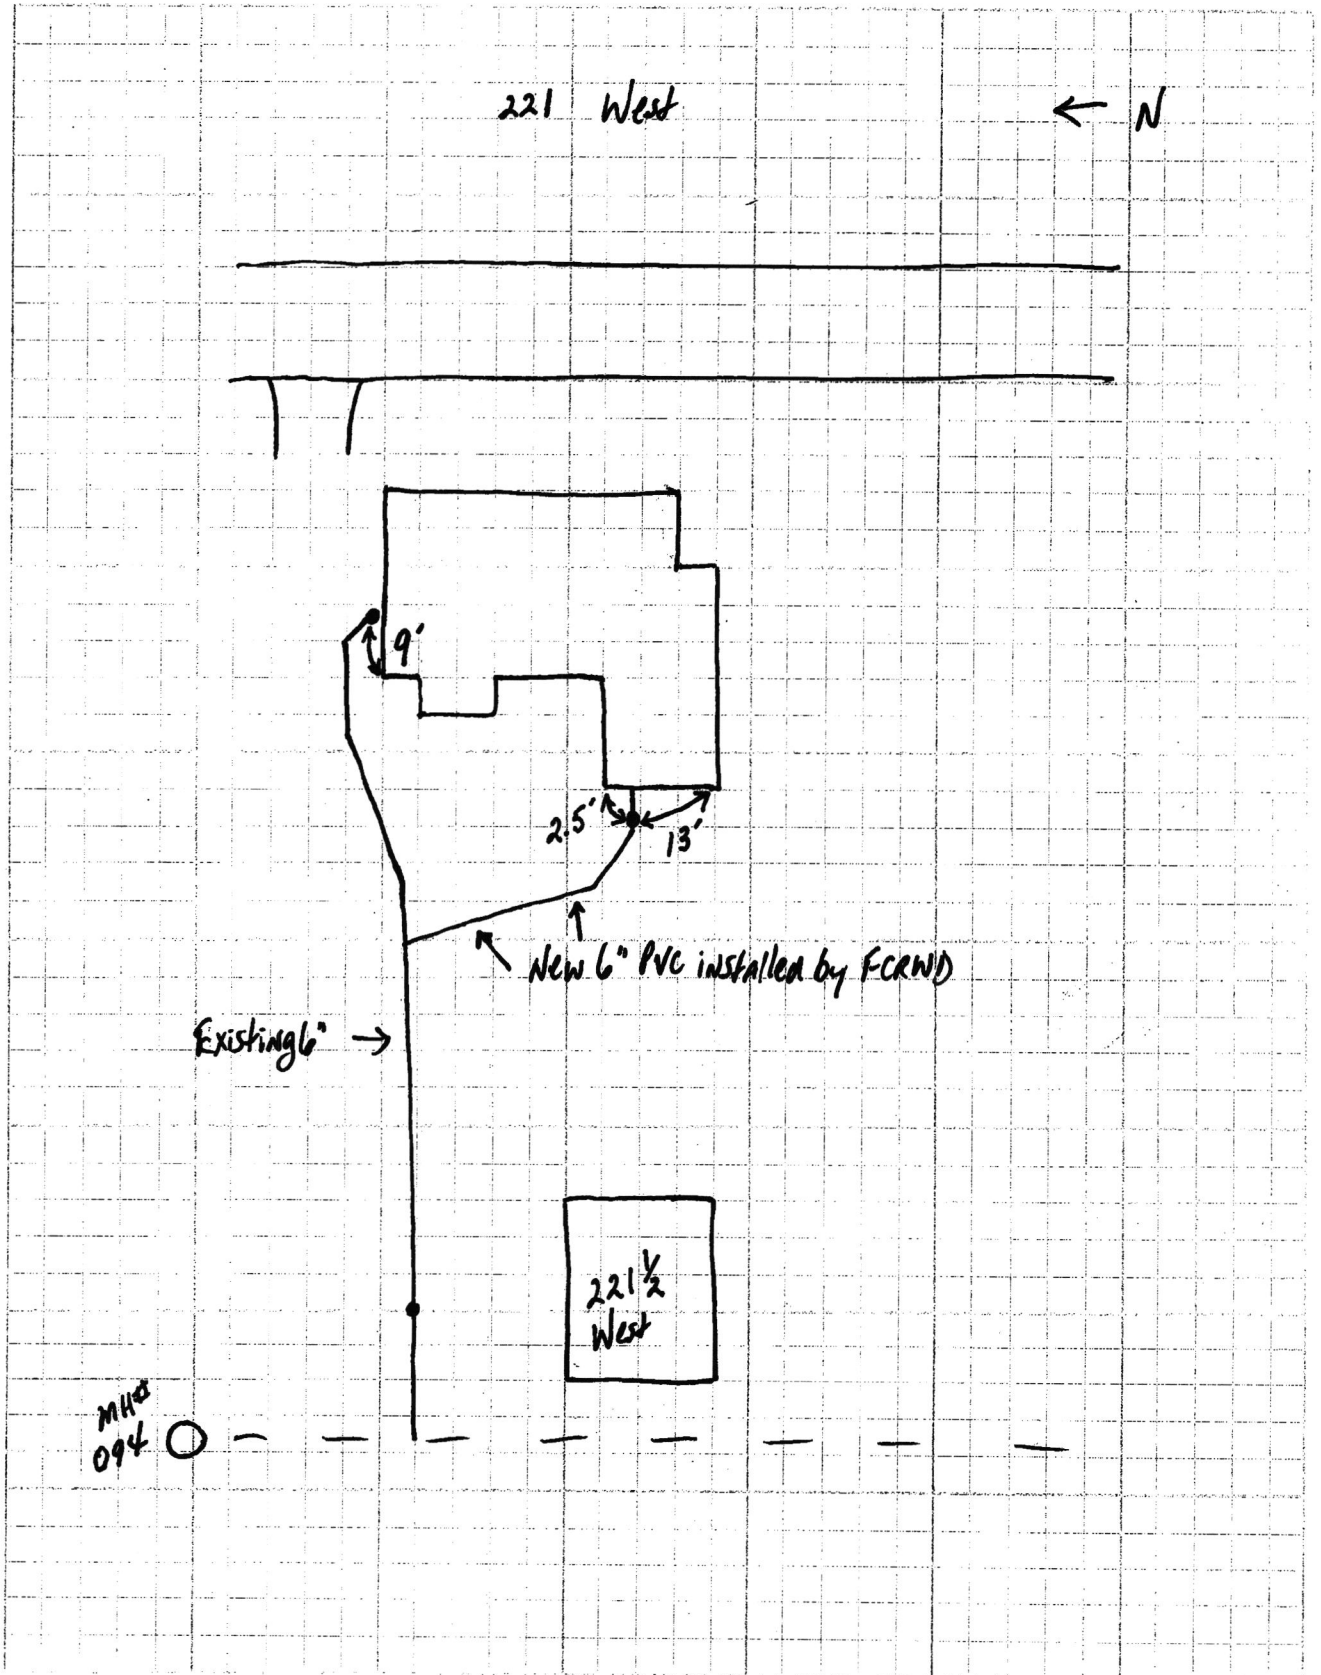

221 West St

SRP Phase II

9.4.18

