

Gidw.

PROJECT Phase II SHEET _____ OF _____


SUBJECT _____ DATE 7-18-18

JOB NO. 4447

BY A+LAS

222 E. State

↑
N

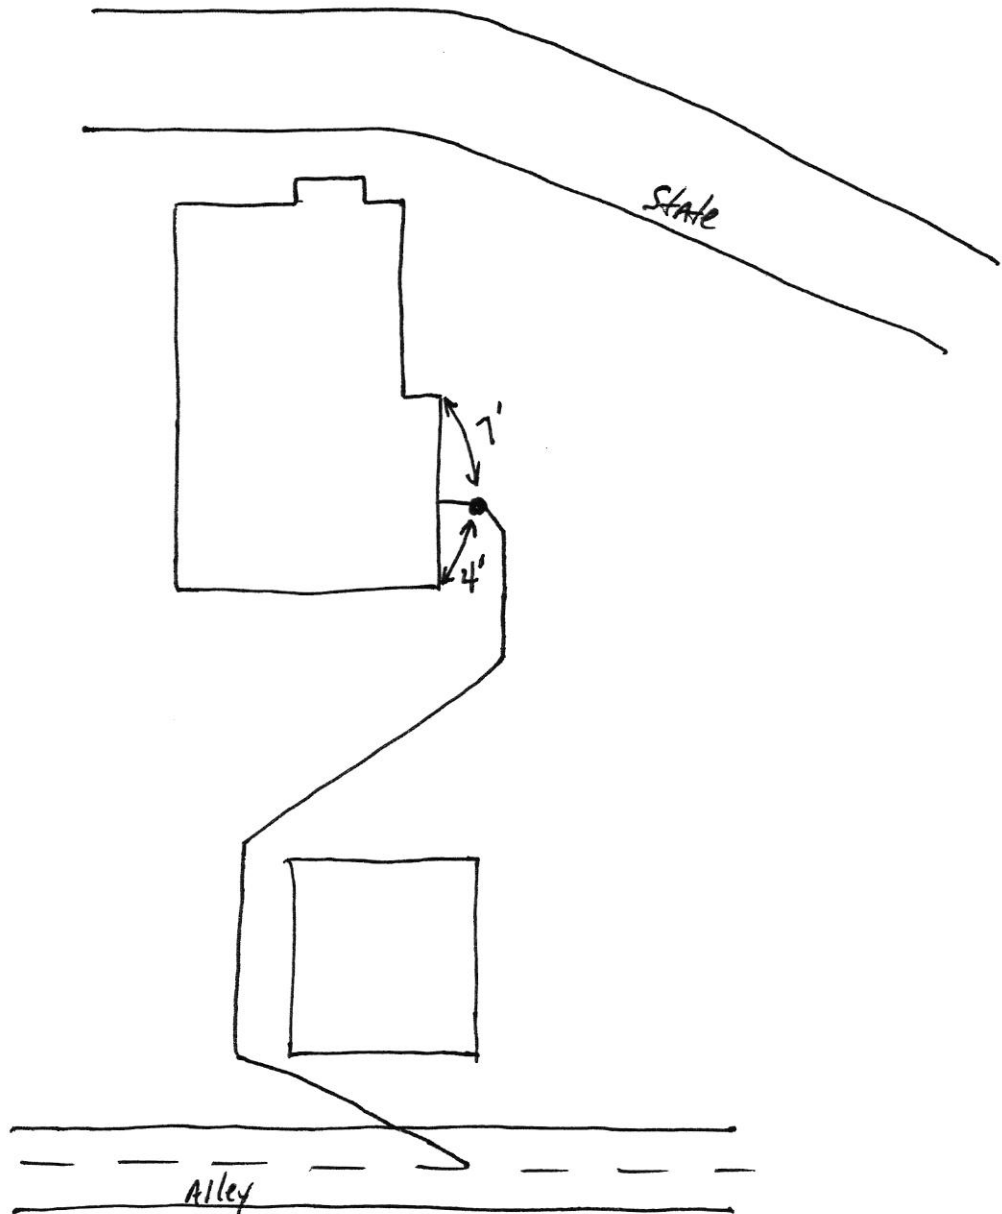

aaa E sheet

Sgt Phase II

7-30-18













