

Gidw.

PROJECT Phase II SHEET _____ OF _____


SUBJECT _____ DATE 5-21-18

JOB NO. 4447

BY Atlas

220 Walnut?

Garage sits facing Alley

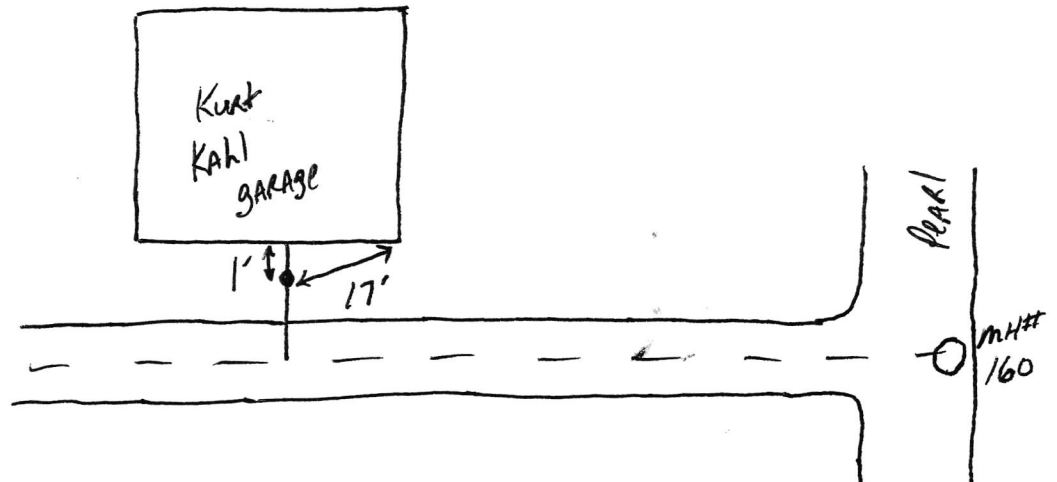

5.22.18

SRP Phase II

garage

