



PROJECT Phase II

SHEET _____ OF _____


SUBJECT _____

DATE 1-19-18

JOB NO. 4447

BY Atlas

222 E Walnut

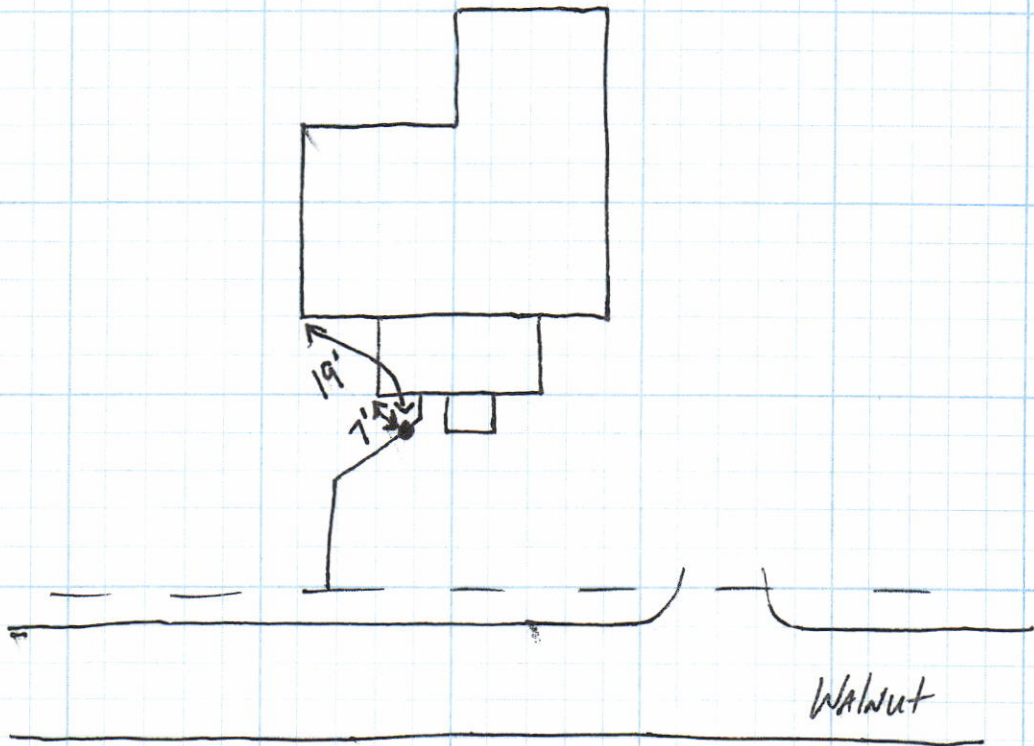

222 E Walnut

SRF Phase II

1.19.18

