

Gidw.

PROJECT PHASE II

SHEET _____ OF _____


SUBJECT _____

DATE 7-3-18

JOB NO. 4447

BY ATLAS

222 S. EAST ST.

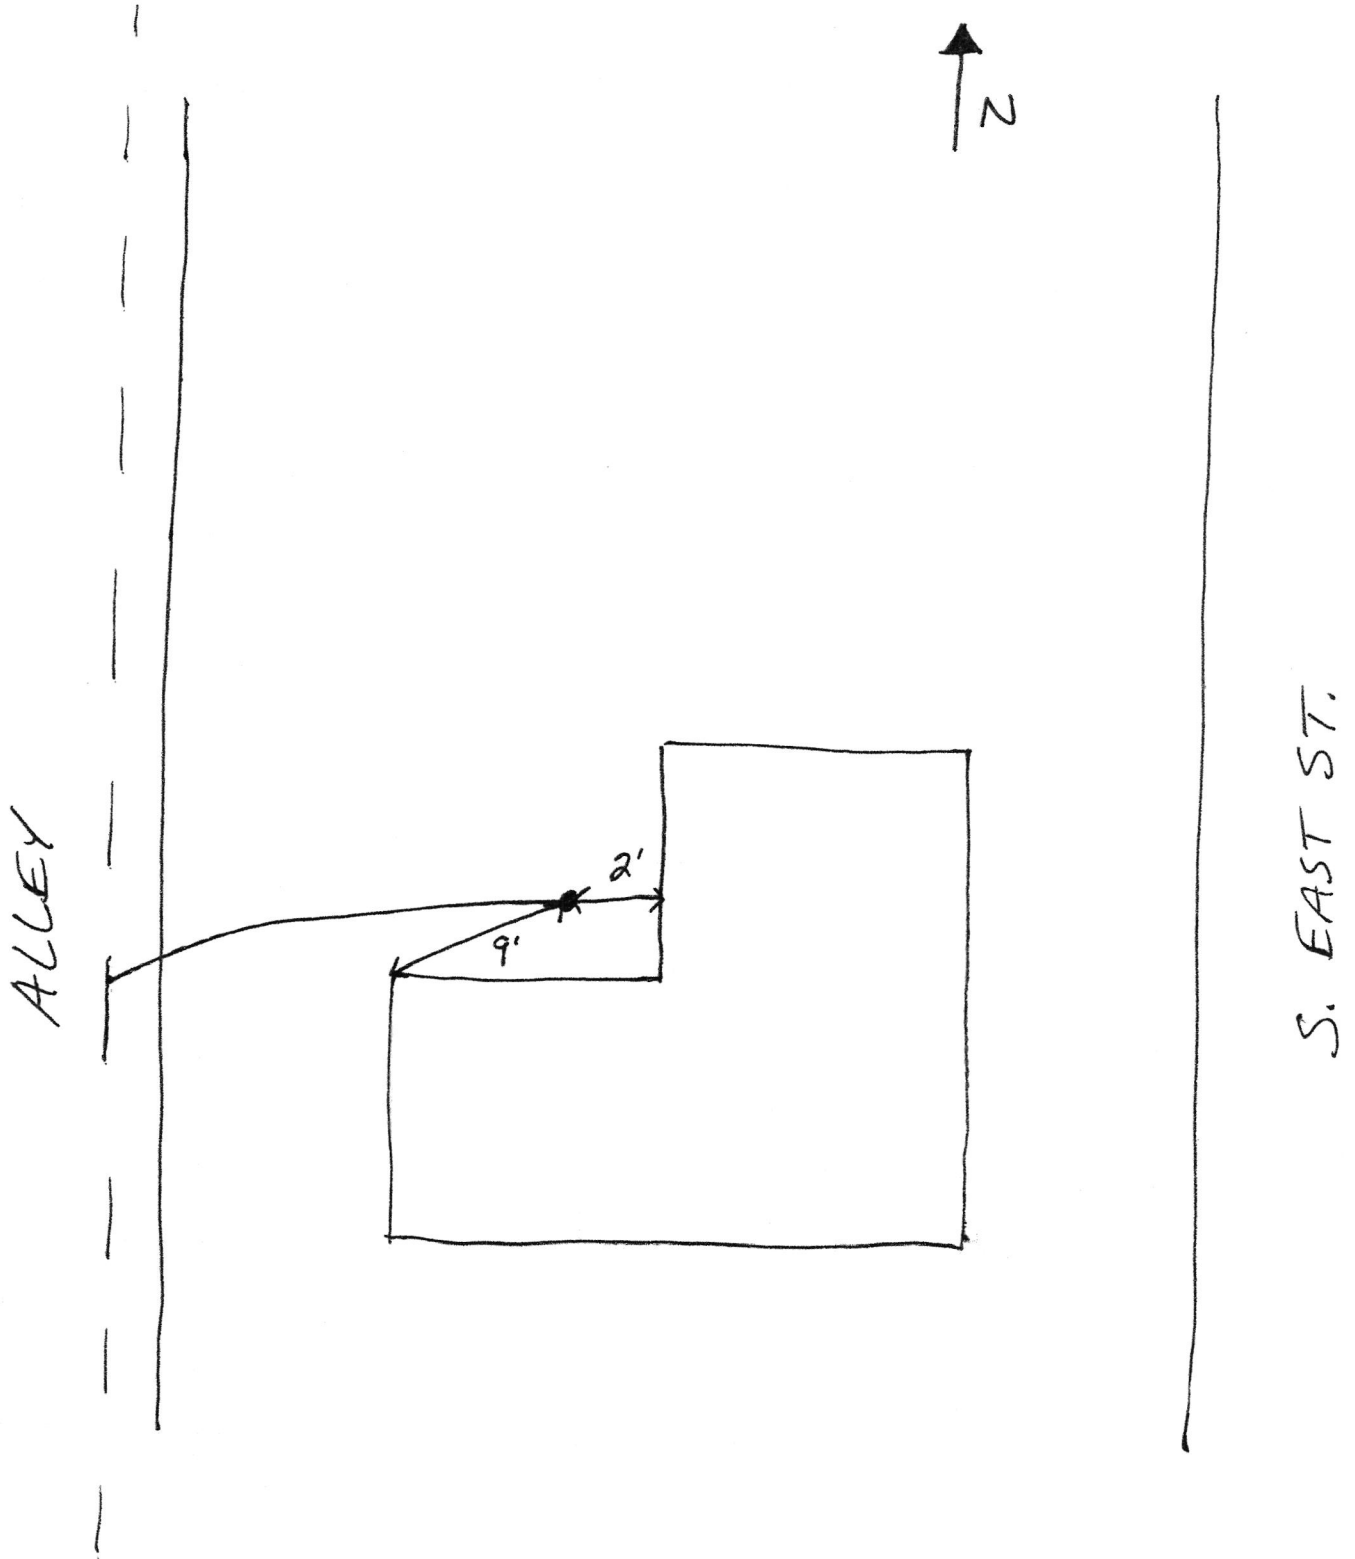

200a East

SPT Phase II

7.6.18

