


Gidw.

PROJECT Phase II SHEET _____ OF _____

SUBJECT _____ DATE 3-12-18

JOB NO. 4447

BY Atlas

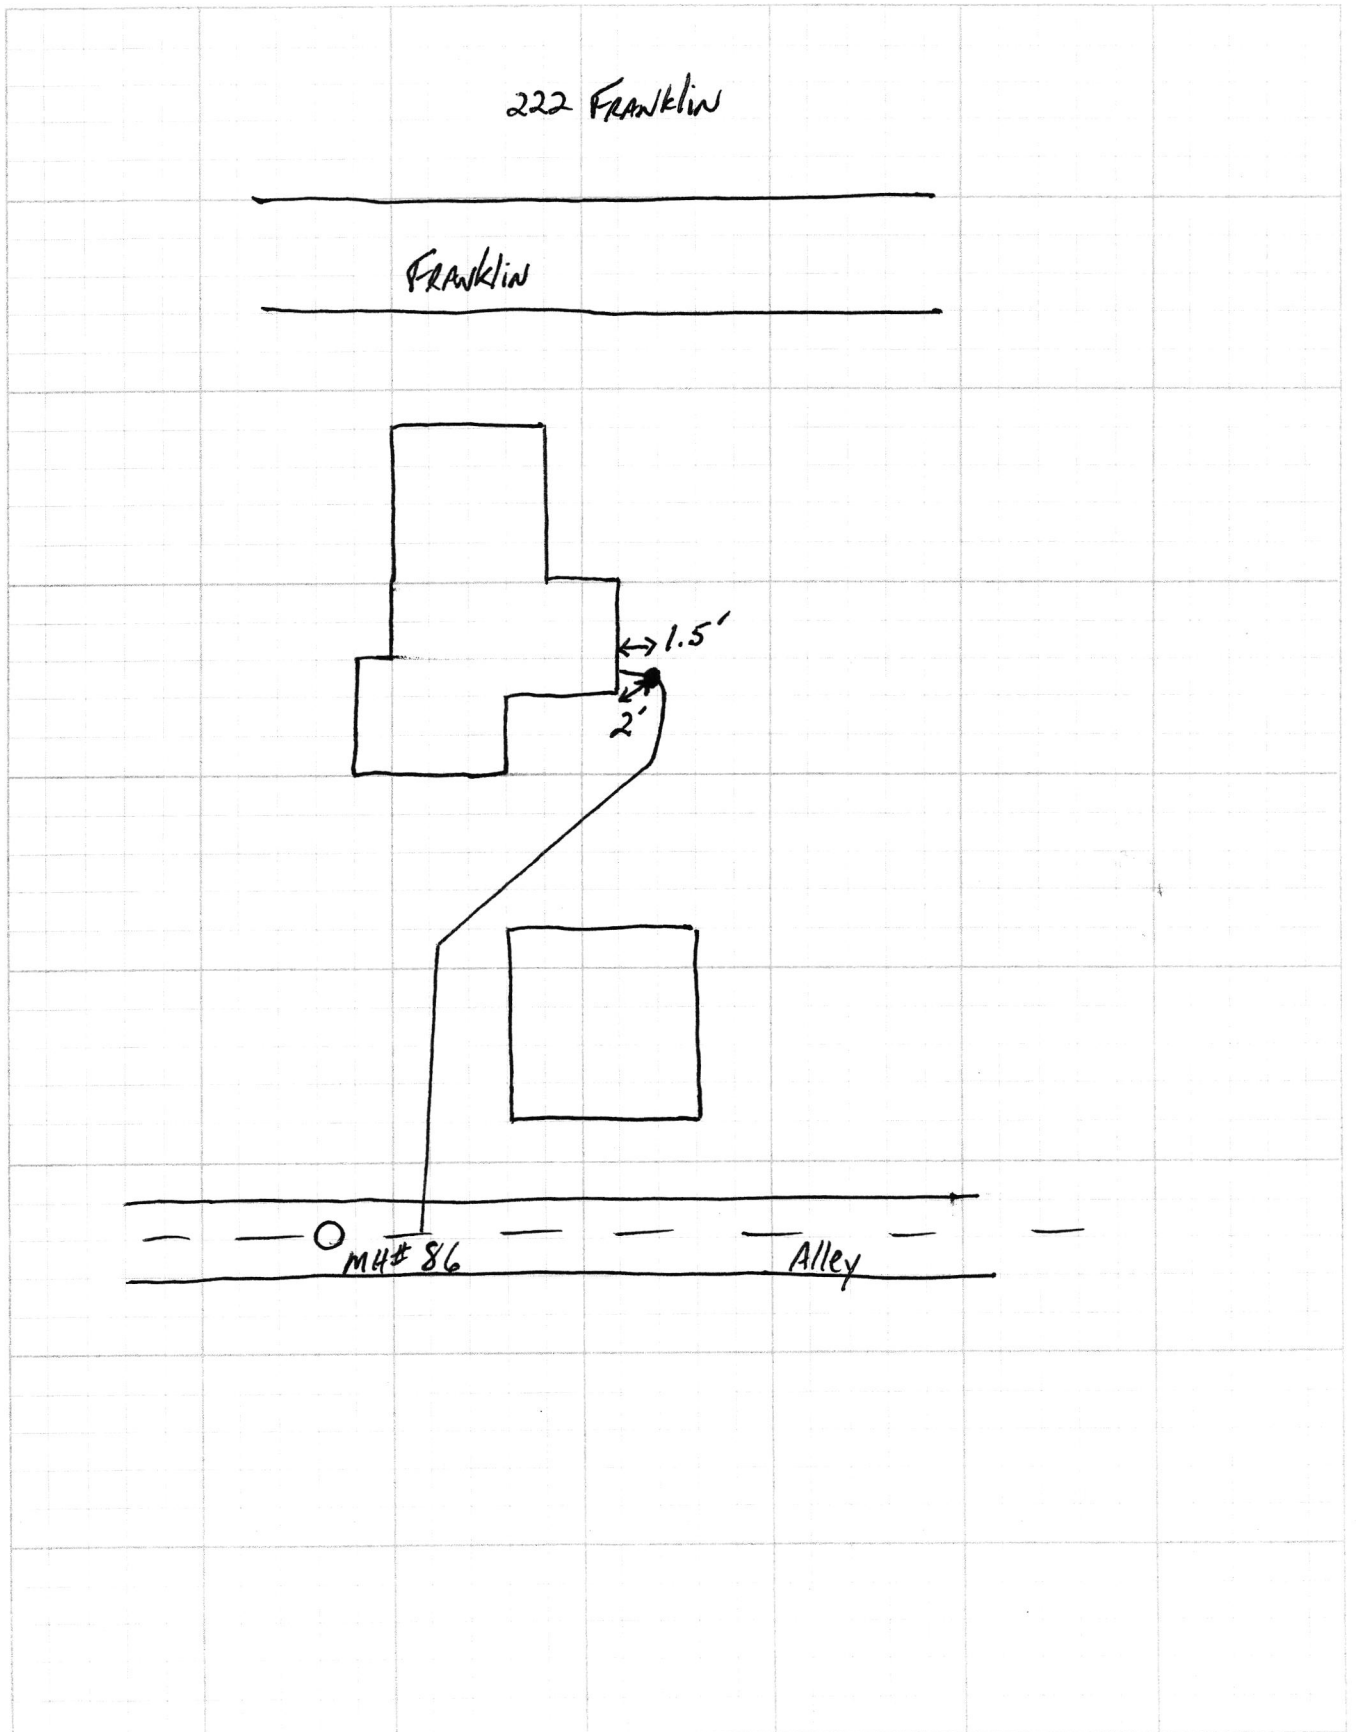

22a Franklin

SRP Phase II

