

Gidw.

PROJECT Phase II SHEET _____ OF _____


SUBJECT _____ DATE 7-19-18

JOB NO. 4447

BY Atlas

222 S. Pearl

← N

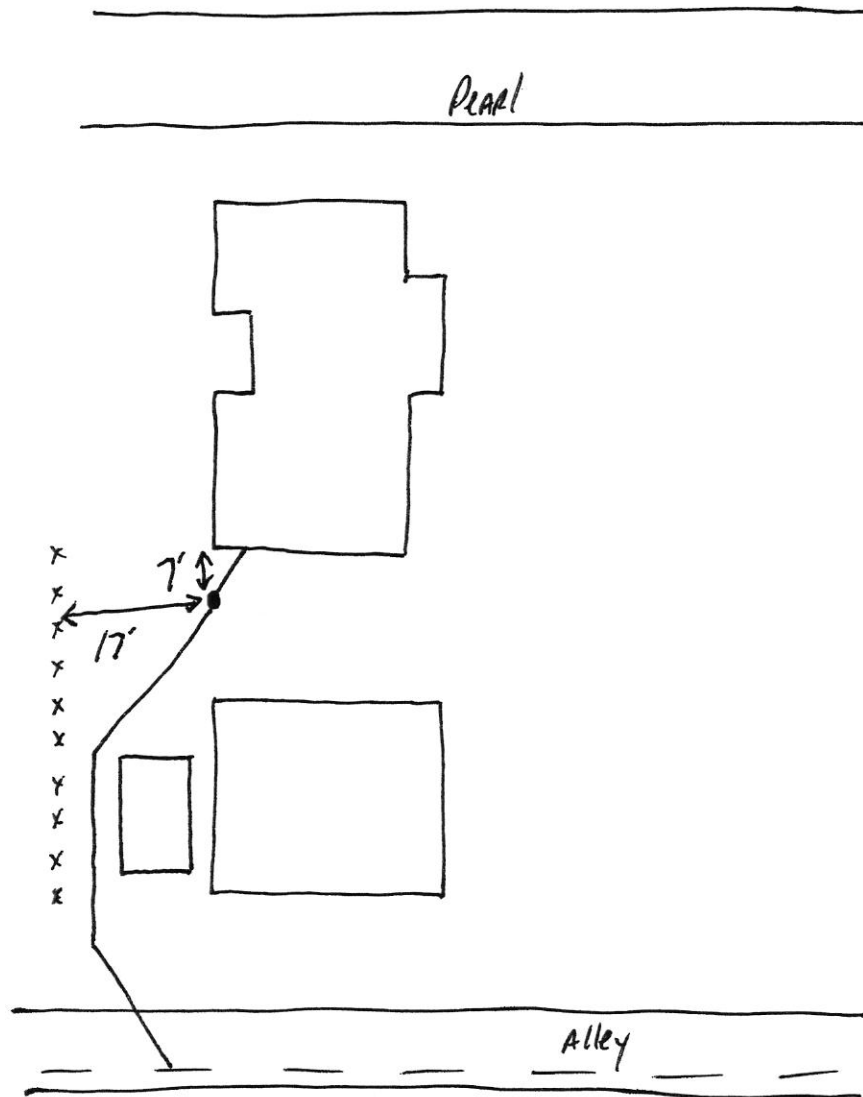

aaa Pearl

SRF Phase II

7.30.18

