

Gidw.


PROJECT Phase II SHEET _____ OF _____

SUBJECT _____ DATE 2-12-18

JOB NO. 4447

BY Atlas

222 S. Main

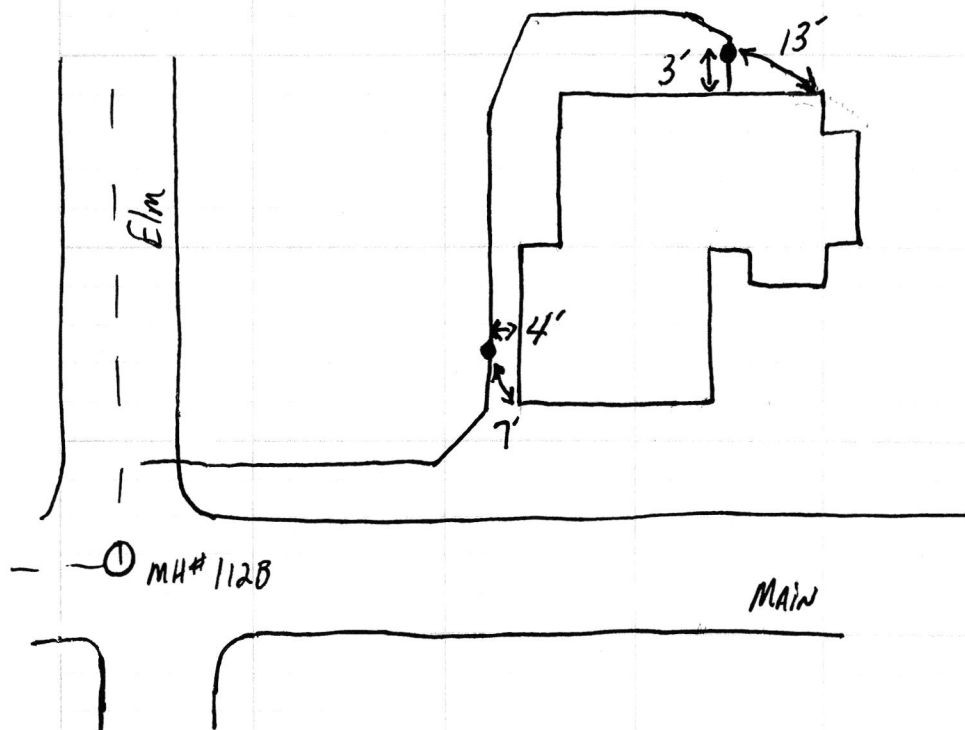

222 S Main

SRF Phase II



222 S Main

SRF Phase II

