

Gidw.

PROJECT Phase II SHEET _____ OF _____

SUBJECT _____ DATE 7-5-18


JOB NO. 4447

BY Atlas

223 S. Pearl

N →

Pearl

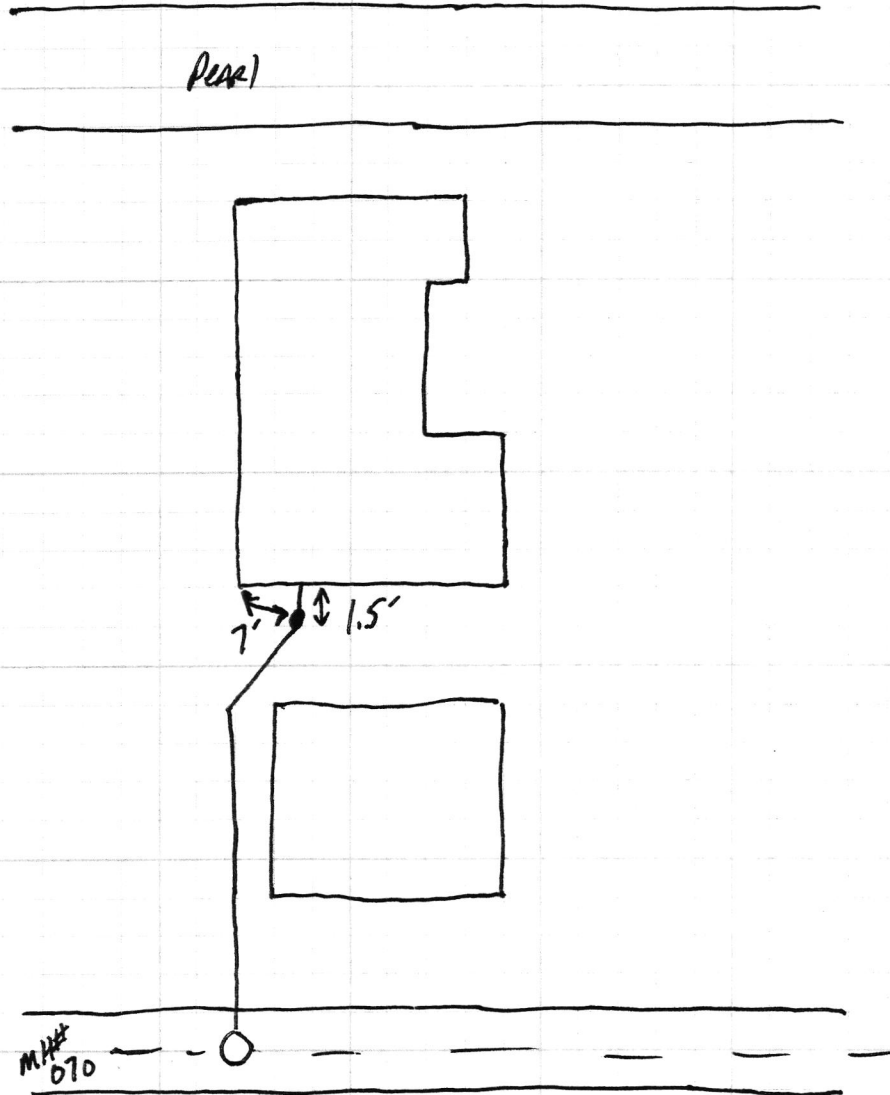

7-6-18

Sgt Phase II

223 Pearl

