


PROJECT Phase II SHEET _____ OF _____
SUBJECT _____ DATE 4-25-18
JOB NO. 4447
BY Atlas

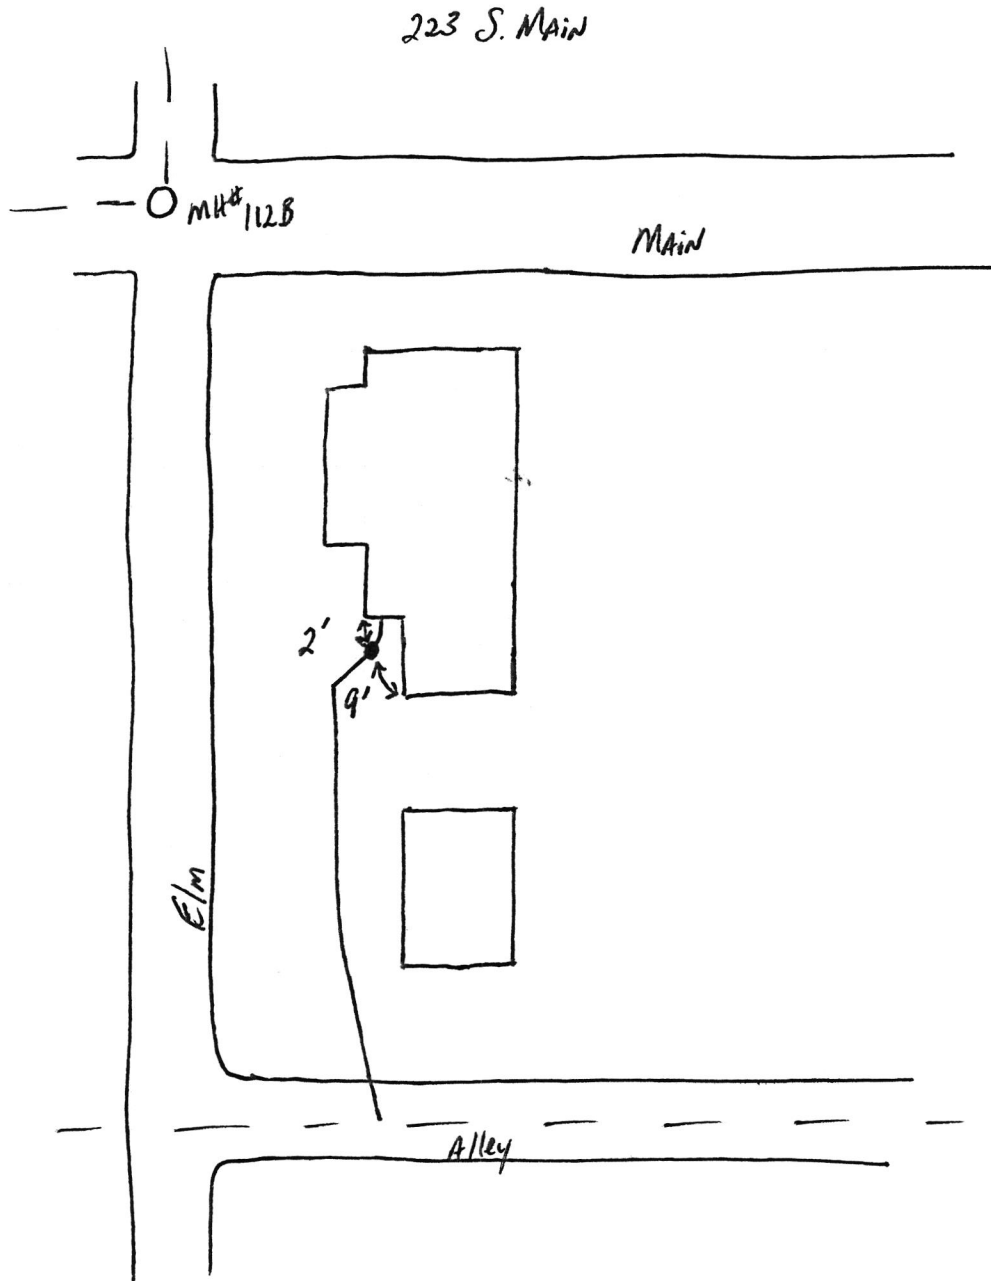

223 S Main

SRP
Phase II

5.3.18

