

Gidw.


PROJECT Phase II SHEET _____ OF _____

SUBJECT _____ DATE 4/6-18

JOB NO. 4447

BY Atlas

223 West High

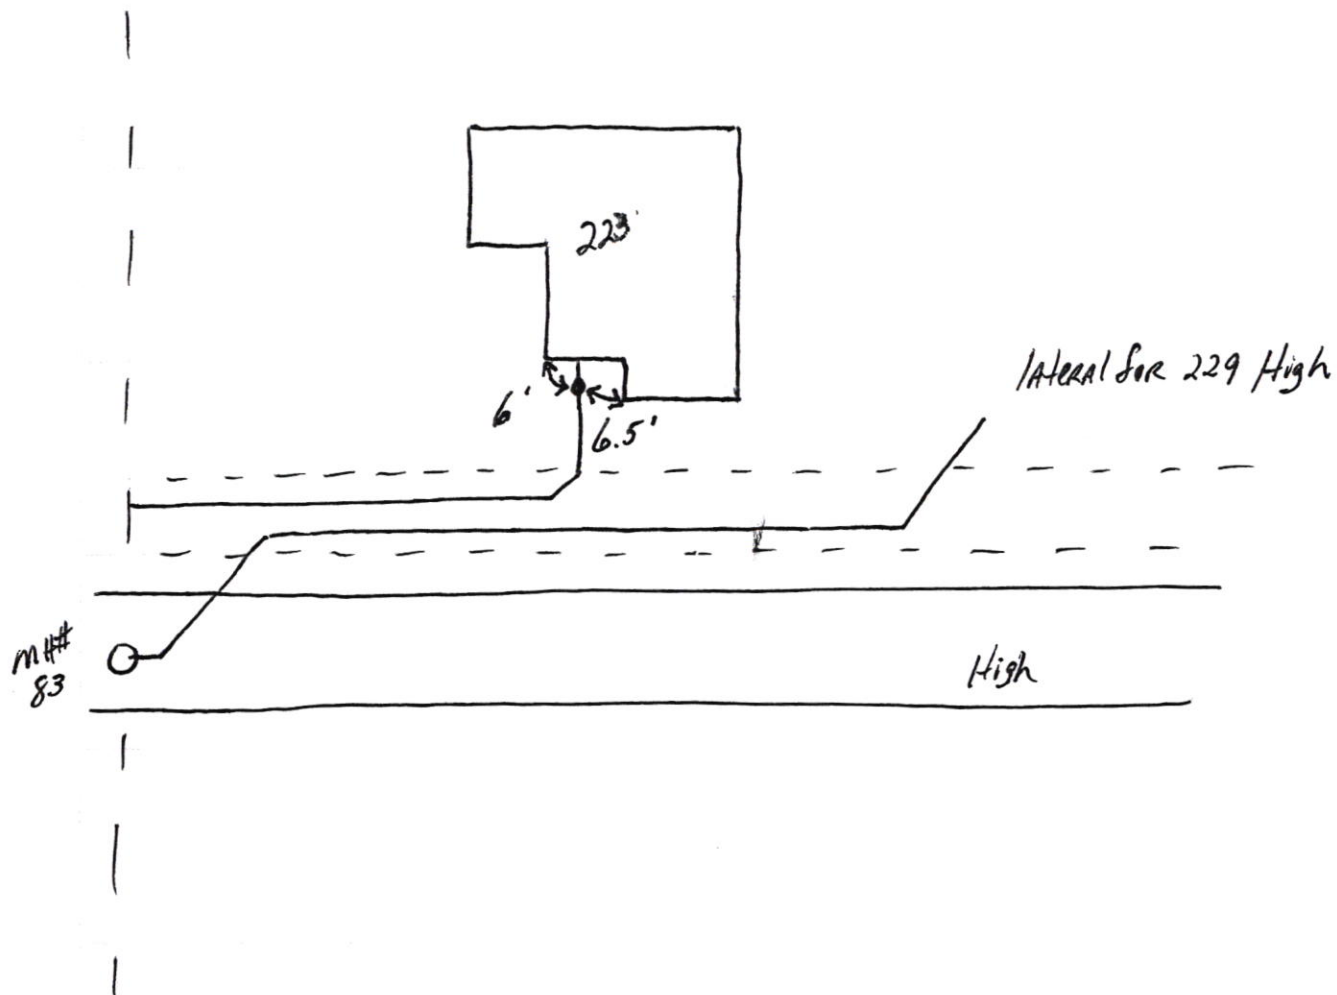

223 W High

SAP
Phase II

4.20.18

