


Gidw.

PROJECT Phase II SHEET _____ OF _____

SUBJECT _____ DATE 8-6-18

JOB NO. 4447

BY Atlas

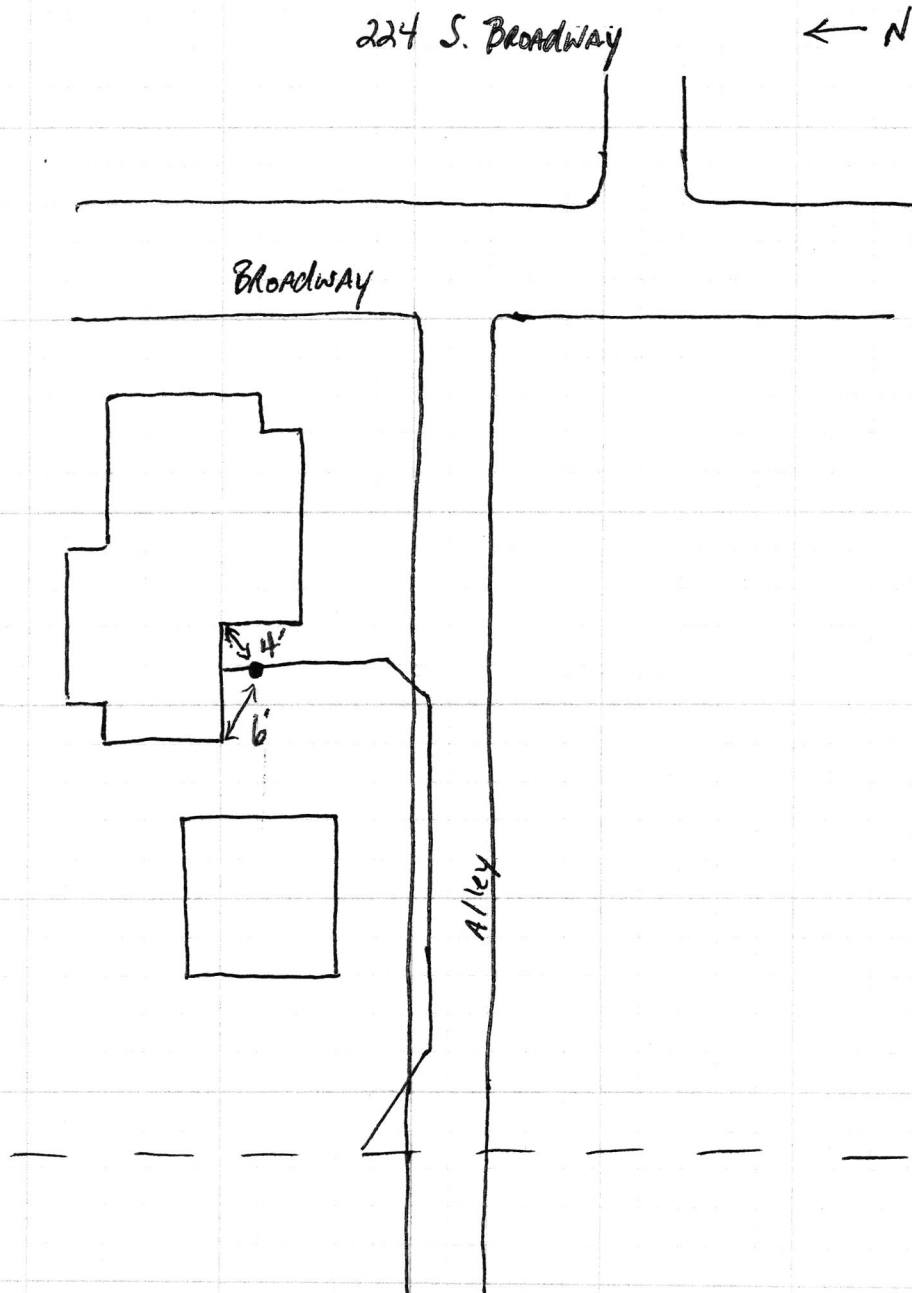



8-15-18

11:58 AM