


G.R.W.

PROJECT Phase II SHEET _____ OF _____
SUBJECT _____ DATE 7-13-18
JOB NO. 4467
BY Atlas

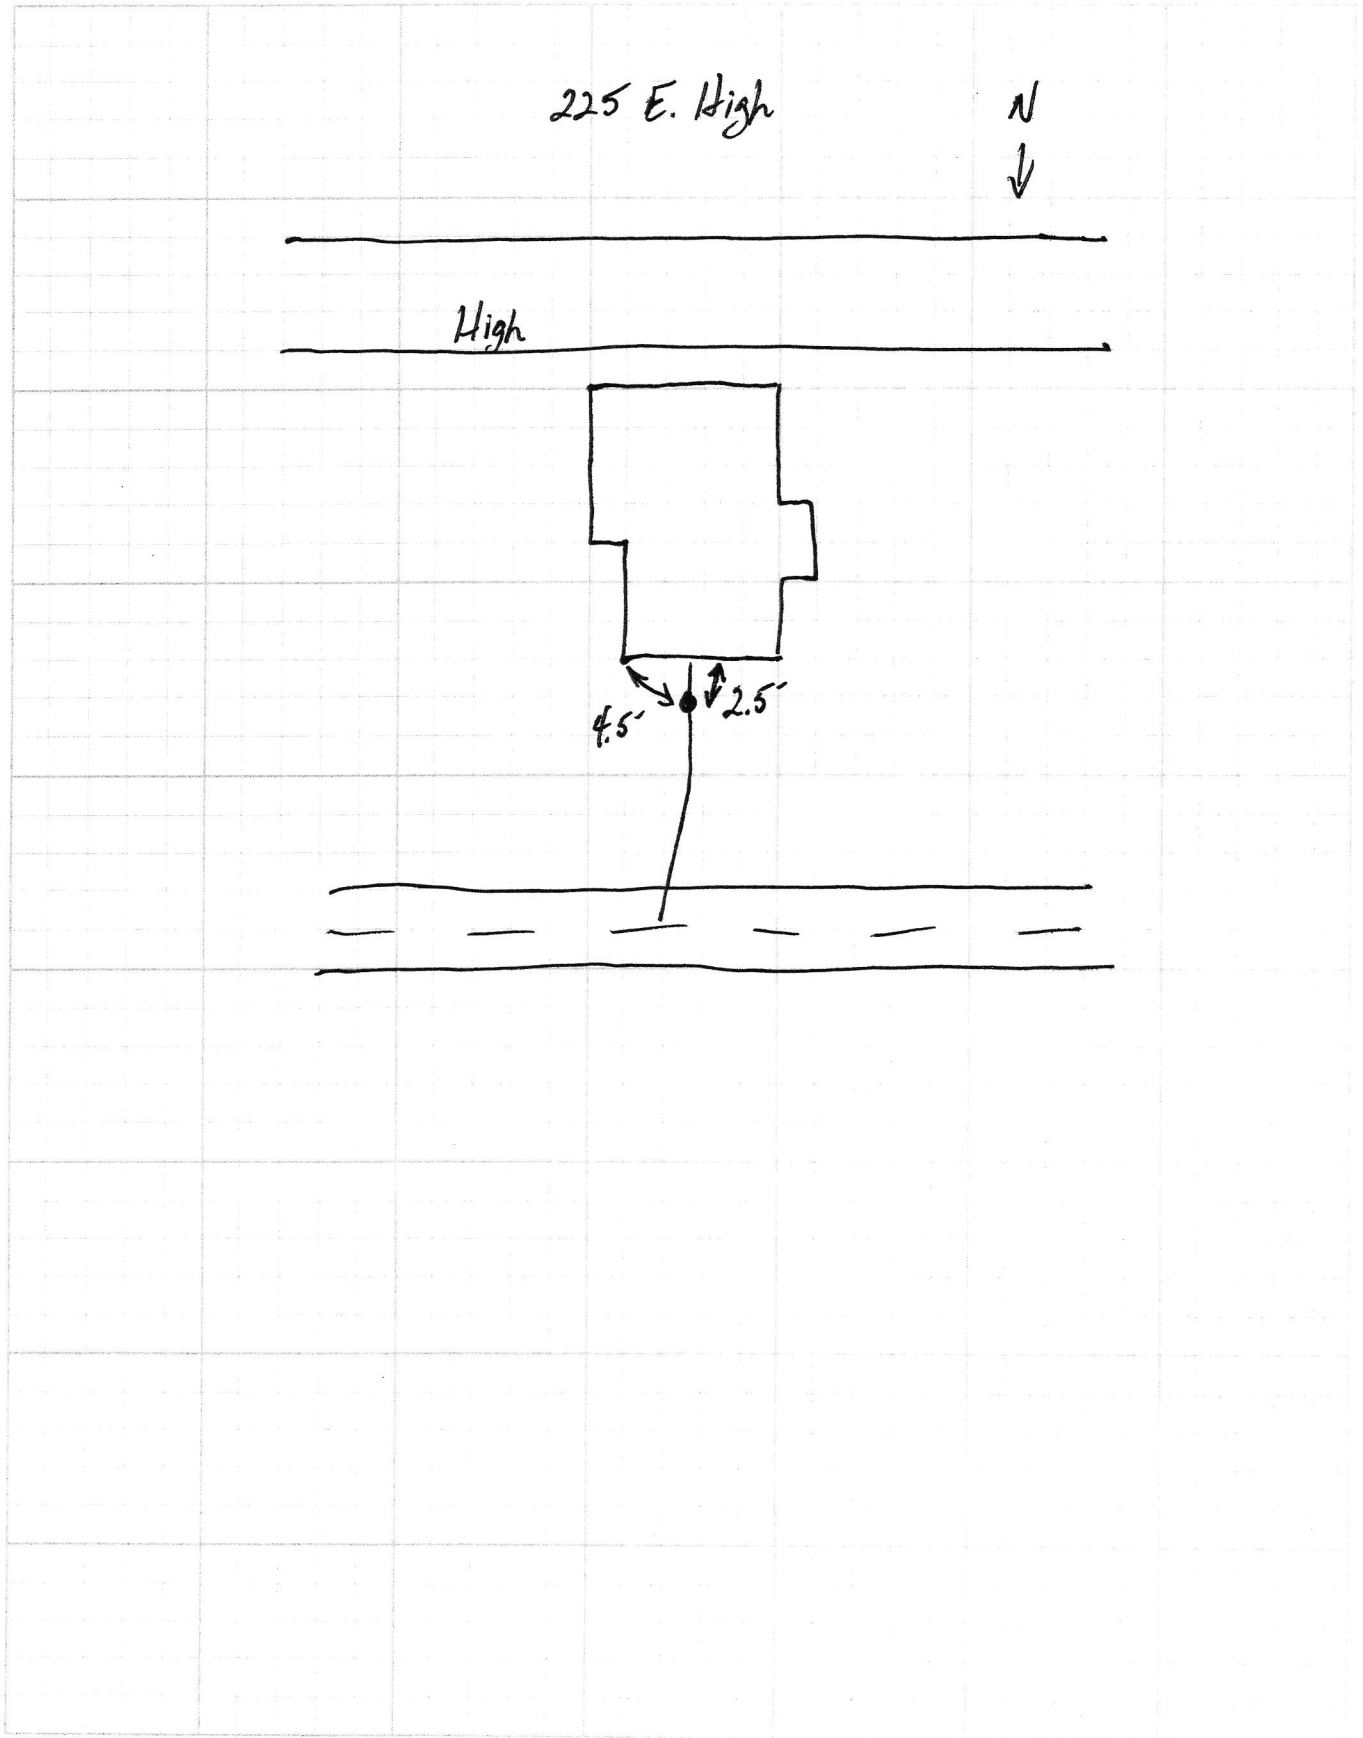

205 & High

SRT Phase II

7.18.18

