

Gidw.

PROJECT

Phase II

SHEET

OF

SUBJECT

DATE

7-16-18

JOB NO

4447


BY

Atlas

225 S. Broadway

N →

BROADWAY

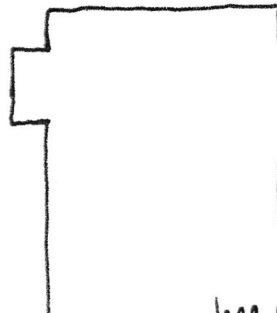

Time Replace original
with this one



Alley

993 Broadway

SRF Phase II


8.15.18



225 S Broadway

SPT Phase II

7.18.18

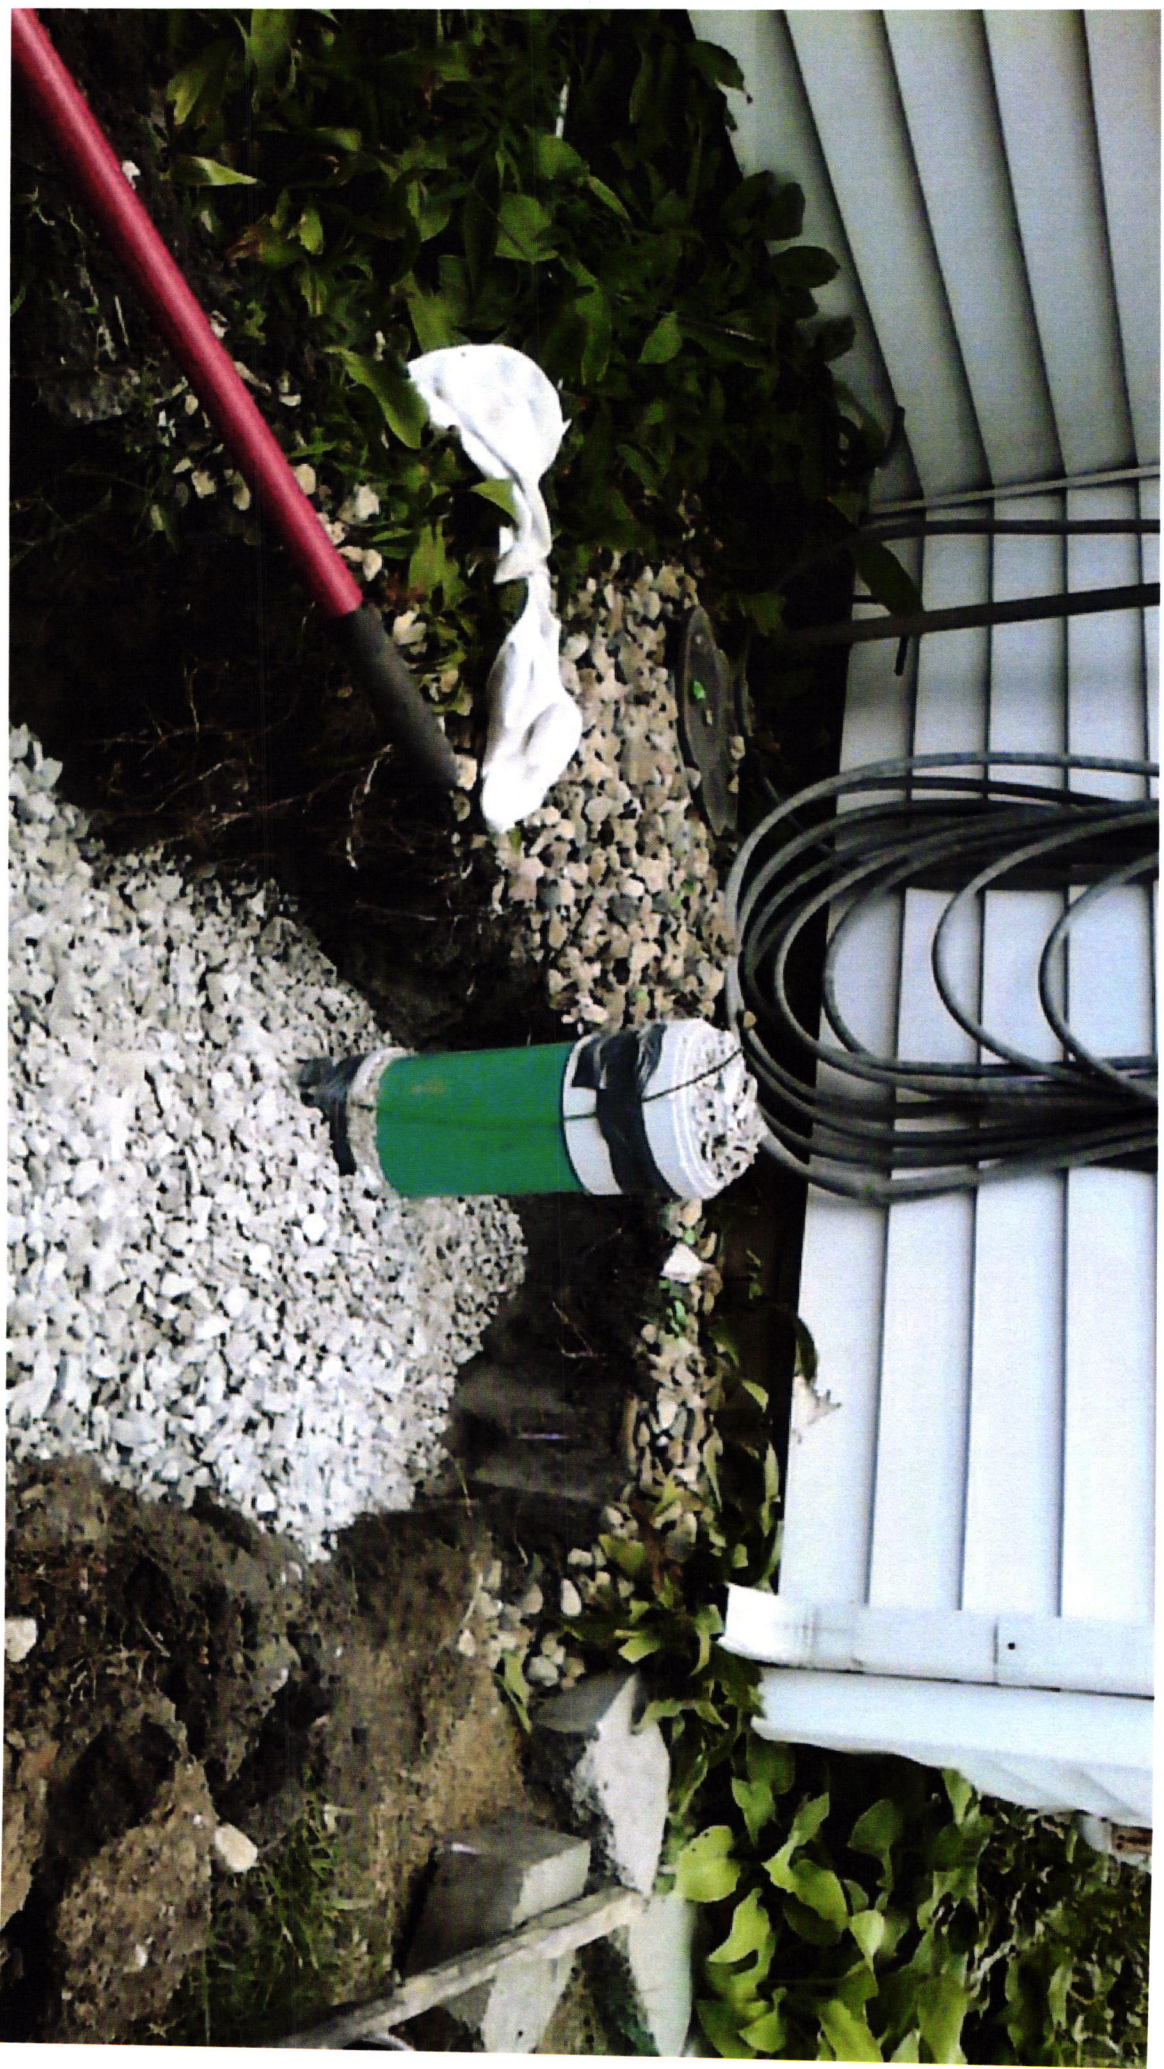

Gidw.

PROJECT Phase II SHEET _____ OF _____
SUBJECT _____ DATE 7-16-18
JOB NO. 4447
BY A+las

225 S. Broadway

N →

